



MASTER

PARENT PARCEL: 03-00-001-000-095

CHILD PARCEL: 03-00-001-000-129, -130

STARTING POINT: INTERSECTION OF HOAG DRIVE AND ABBE RD.

NO. 01096

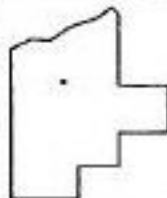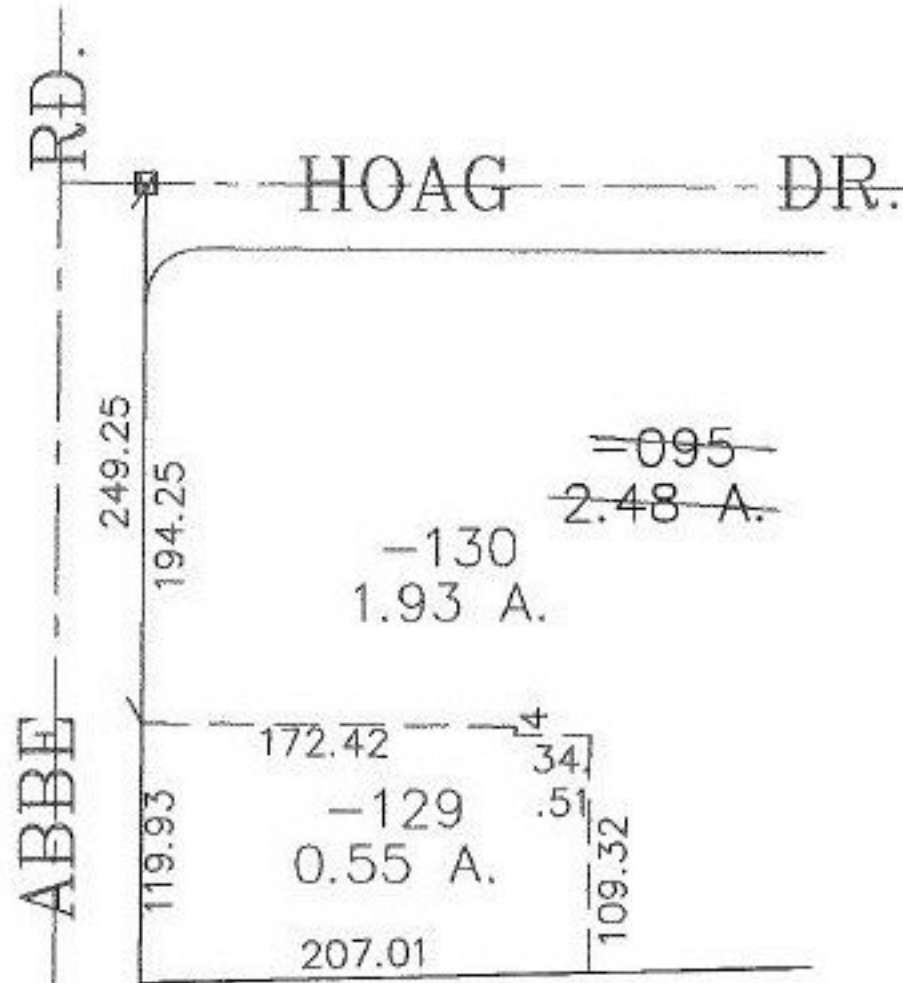

SPLITS/DEEDS PROCESSED

LORAIN COUNTY TAX MAP DEPARTMENT
226 MIDDLE AVE. ELYRIA, OHIO

SURVEYED BY: CARL ANDERSON
 CLOSURE: 0.00 : 10.000
 MAP PAGE(S): 3-00-001-A
 APPROVED BY: JAH DATE: 5-30-02
 SCALE: 1" = 100 PRIOR INSTRUMENT: OR 1065/666