
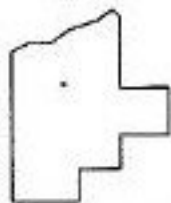


PARENT PARCEL: 03-00-054-102-015

CHILD PARCEL: 03-00-054-102-019, -020

STARTING POINT: CENTERLINE OF LORAIN-AVON RD. & O.L. 54

NO. 01110

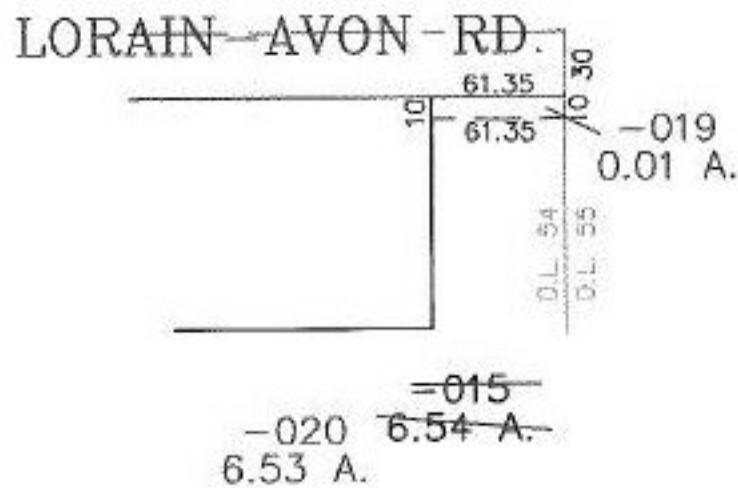

SPLITS/DEEDS PROCESSED

LORAIN COUNTY TAX MAP DEPARTMENT
226 MIDDLE AVE. ELYRIA, OHIO

SURVEYED BY: BRIAN P. MCCARTNEY

CLOSURE: 0.00 : 10.000

MAP PAGE(S): 3-A

APPROVED BY: JAH DATE: 6-13-02

SCALE: 1" = 100' PRIOR INSTRUMENT: OR 1049/725