



RASTER

PARENT PARCEL: 04-00-011-103-008, -010

CHILD PARCEL: 04-00-011-103-028

STARTING POINT: CENTERLINE OF DETROIT RD. & FRENCH CREEK RD.

NO. 01118

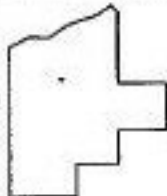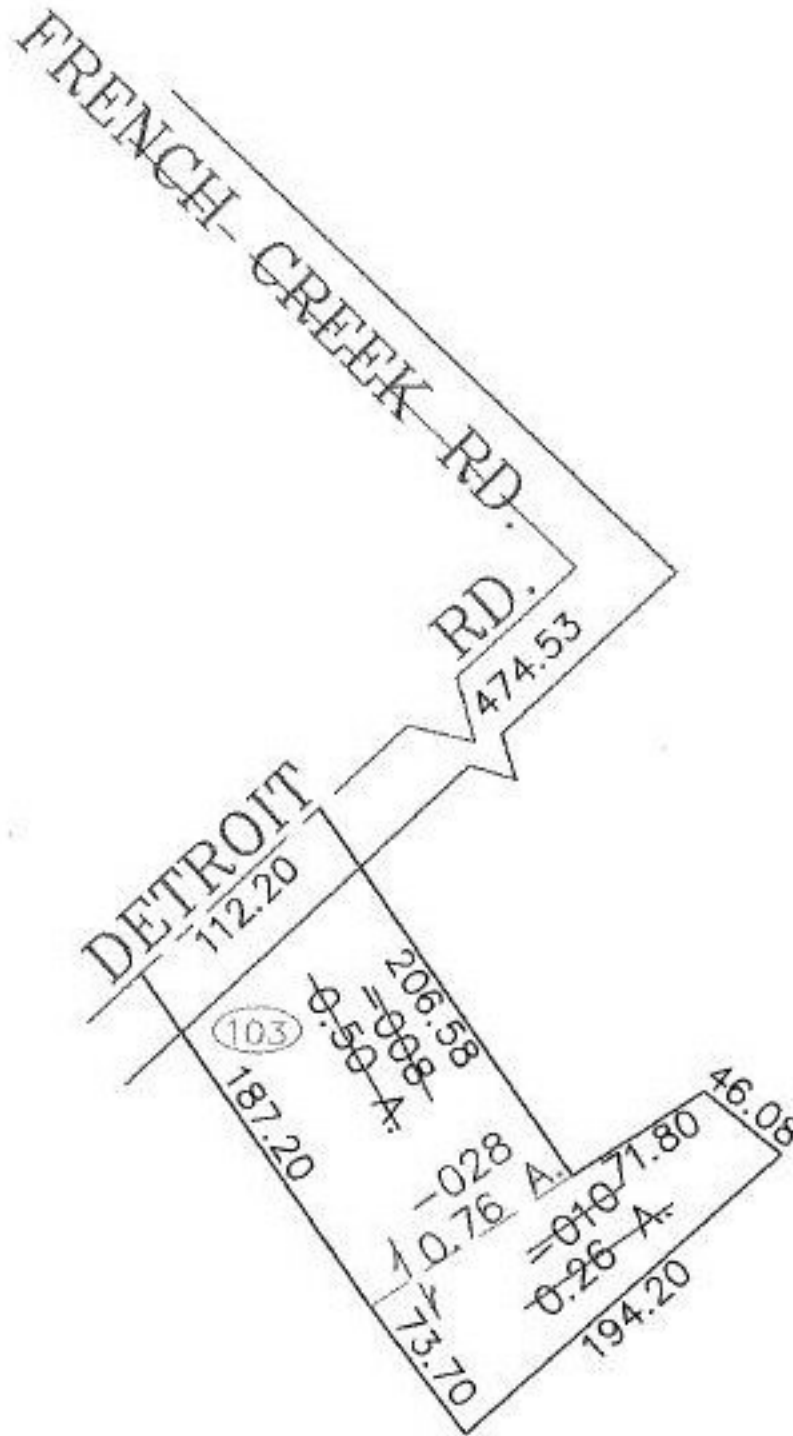

**SPLITS/DEEDS PROCESSED**

LORAIN COUNTY TAX MAP DEPARTMENT  
226 MIDDLE AVE. ELYRIA, OHIO

SURVEYED BY: VINCENT C. MCGERVEY

CLOSURE: 0.00 : 10.000

MAP PAGE(S): 4-00-011-B

APPROVED BY: JAH DATE: 6-19-02

SCALE: 1" = 100' PRIOR INSTRUMENT: DV 1358/434