
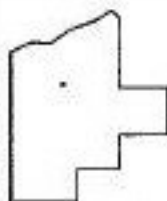


PARENT PARCEL: 06-22-006-101-004

CHILD PARCEL: 06-22-006-101-019, -020

STARTING POINT: CENTERLINE OF FORD RD. & O.L. 6

NO. 01125

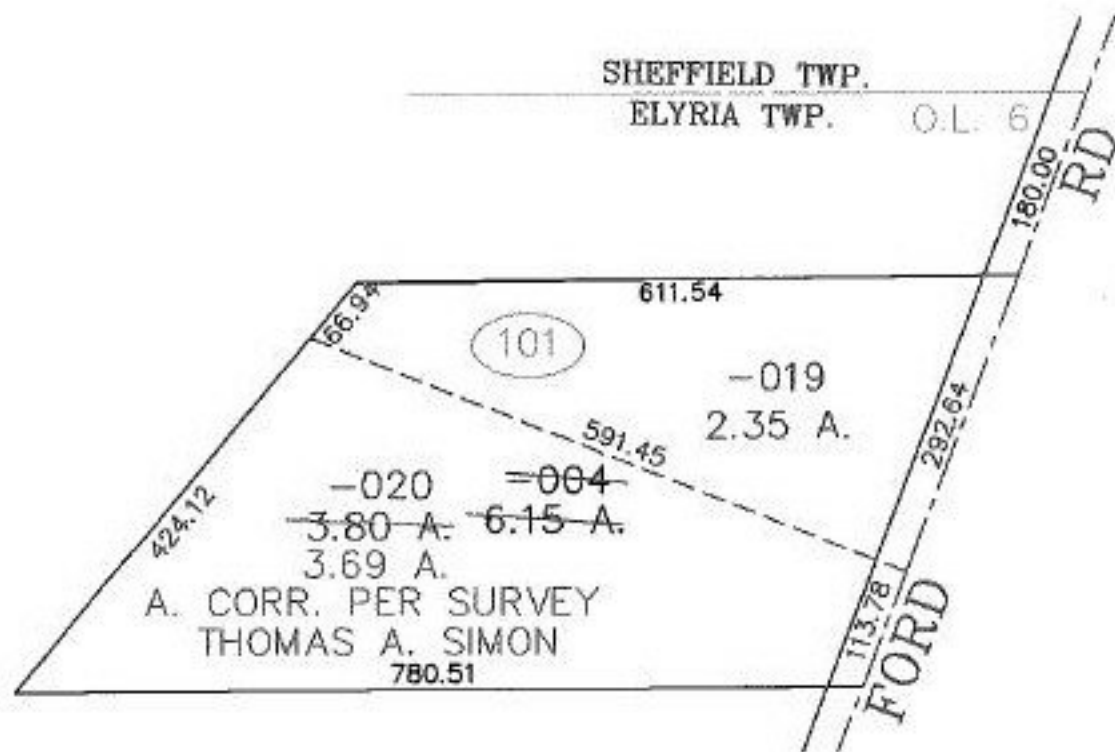

SPLITS/DEEDS PROCESSED
 LORAIN COUNTY TAX MAP DEPARTMENT
 226 MIDDLE AVE. ELYRIA, OHIO

SURVEYED BY: THOMAS A. SIMON
 CLOSURE: 0.00 : 10.000
 MAP PAGE(S): 6-13
 APPROVED BY: JAH DATE: 6-28-02
 SCALE: 1" = 200' PRIOR INSTRUMENT: DV 1397/798