
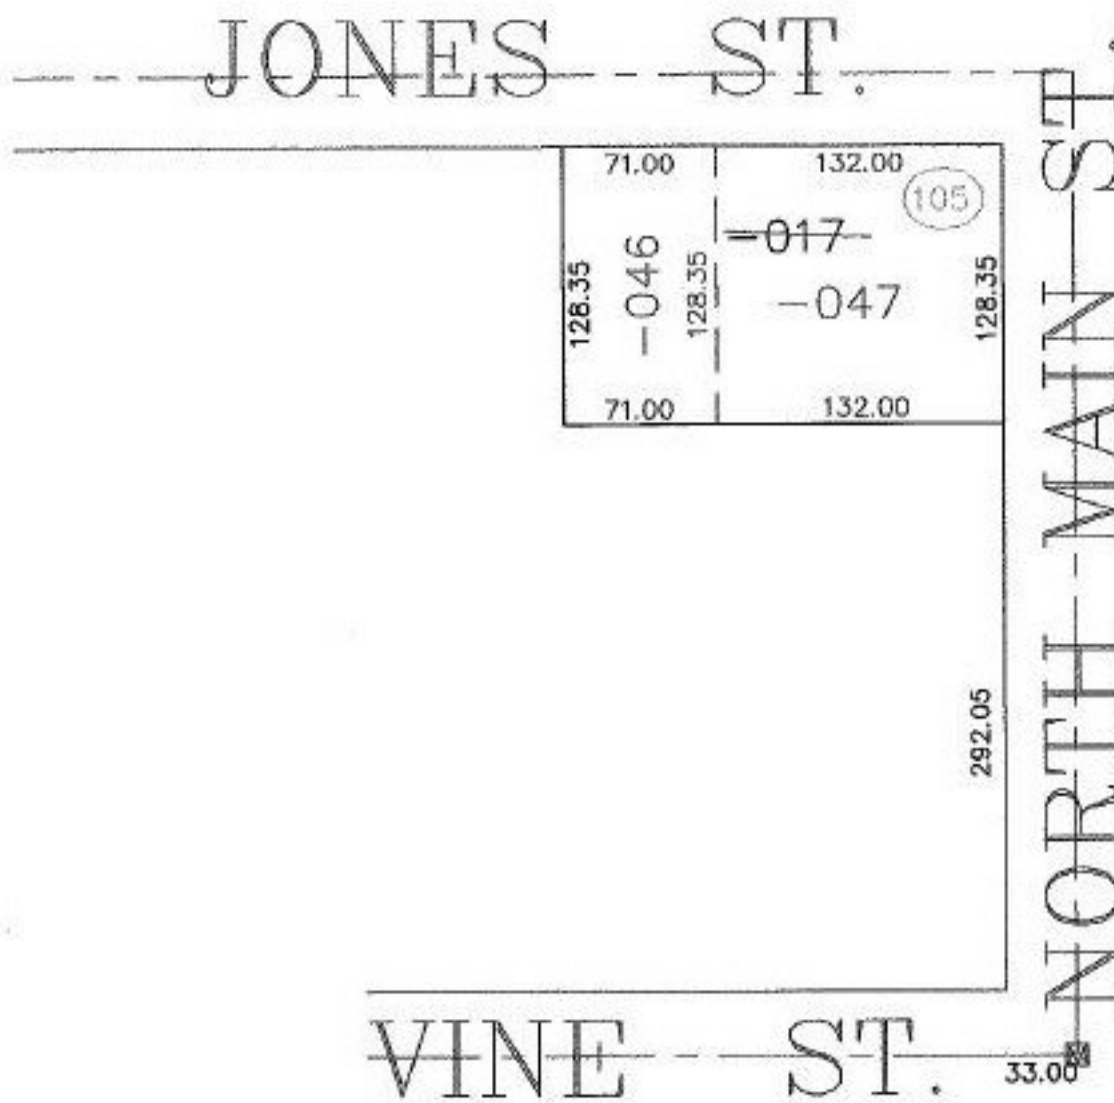


PARENT PARCEL: 18-00-028-105-017

CHILD PARCEL: 18-00-028-105-046, -047

STARTING POINT: CENTERLINE OF VINE ST. & NORTH MAIN ST.

NO. 01126

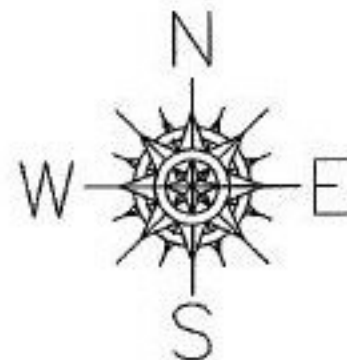

**SPLITS/DEEDS PROCESSED**

LORAIN COUNTY TAX MAP DEPARTMENT  
226 MIDDLE AVE. ELYRIA, OHIO

SURVEYED BY: THOMAS M. SNEZEK

CLOSURE: 0.00 : 10.000

MAP PAGE(S): 18-00-028-0

APPROVED BY: JAH DATE: 6-28-02

SCALE: 1" = 100' PRIOR INSTRUMENT: 20020814188