



RASTER

PARENT PARCEL: 07-00-036-000-053

CHILD PARCEL: 07-00-036-000-188 THRU -190

STARTING POINT: NORTHWESTERLY CORNER OF BLOCK "E" OF WATERBURY SUBD. NO 1

NO. 01128

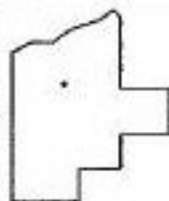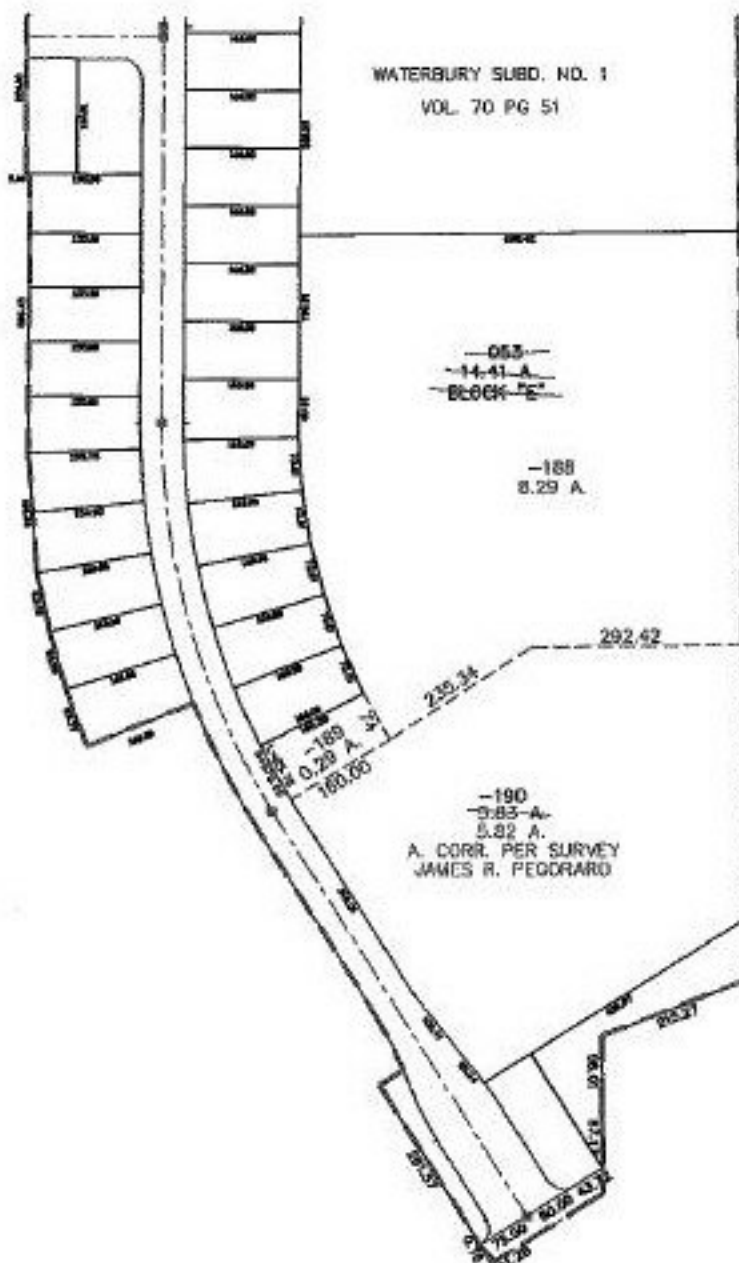

SPLITS/DEEDS PROCESSED  
LORAIN COUNTY TAX MAP DEPARTMENT  
226 MIDDLE AVE. ELYRIA, OHIO

SURVEYED BY: JAMES R PERGORARO  
CLOSURE: 0.00 : 10.000  
MAP PAGE(S): 7-F, 7-00-036-D  
APPROVED BY: JAH DATE: 6-28-02  
SCALE: 1" = 300' PRIOR INSTRUMENT: PLAT VOL 70/51