


RASTER

PARENT PARCEL: 11-00-089-000-122

CHILD PARCEL: 11-00-089-000-131, -132

STARTING POINT: CENTERLINE OF BUTTERNUT RIDGE RD. & DURKEE RD.

NO. 01129

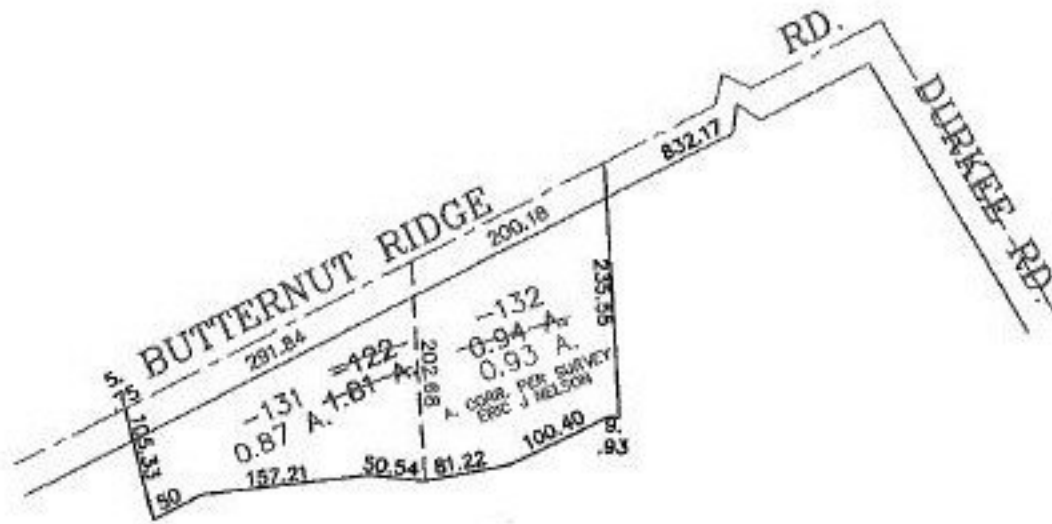

**SPLITS/DEEDS PROCESSED**  
**LORAIN COUNTY TAX MAP DEPARTMENT**  
 226 MIDDLE AVE. ELYRIA, OHIO

SURVEYED BY: ERIC J. NELSON  
 CLOSURE: 0.01 : 10.000  
 MAP PAGE(S): 11-00-089-B  
 APPROVED BY: JAH DATE: 7-1-02  
 SCALE: 1" = 200' PRIOR INSTRUMENT: OR 98/460