



RASTER

PARENT PARCEL: 06-24-014-000-036

CHILD PARCEL: 06-24-014-000-046, -047

STARTING POINT: CENTERLINE OF MURRAY RIDGE RD. & O.L. 14

NO. 01133

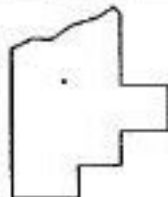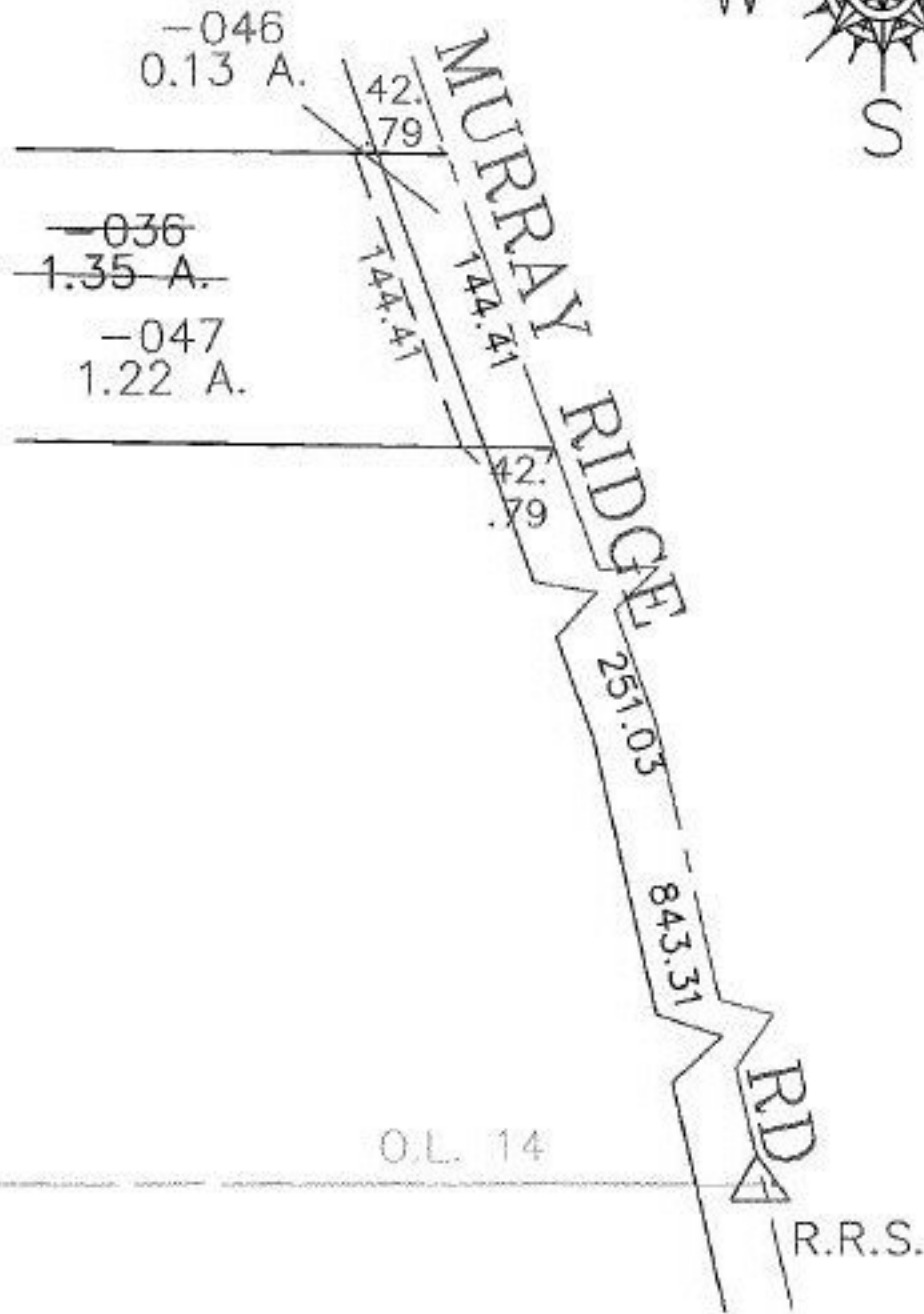

**SPLITS/DEEDS PROCESSED**

LORAIN COUNTY TAX MAP DEPARTMENT  
226 MIDDLE AVE. ELYRIA, OHIO

SURVEYED BY:	MARK A. YEAGER
CLOSURE:	0.00 : 10.000
MAP PAGE(S):	6-112
APPROVED BY:	JAH DATE: 7-3-02
SCALE:	1" = 100' PRIOR INSTRUMENT: 990599445