

RASTER

PARENT PARCEL: 04-00-023-102-001



CHILD PARCEL: 04-00-023-102-037 THRU -039

STARTING POINT: CENTERLINE OF JAYCOX RD. & O.L. 23

NO. 01139



PLOT 1" = 100'

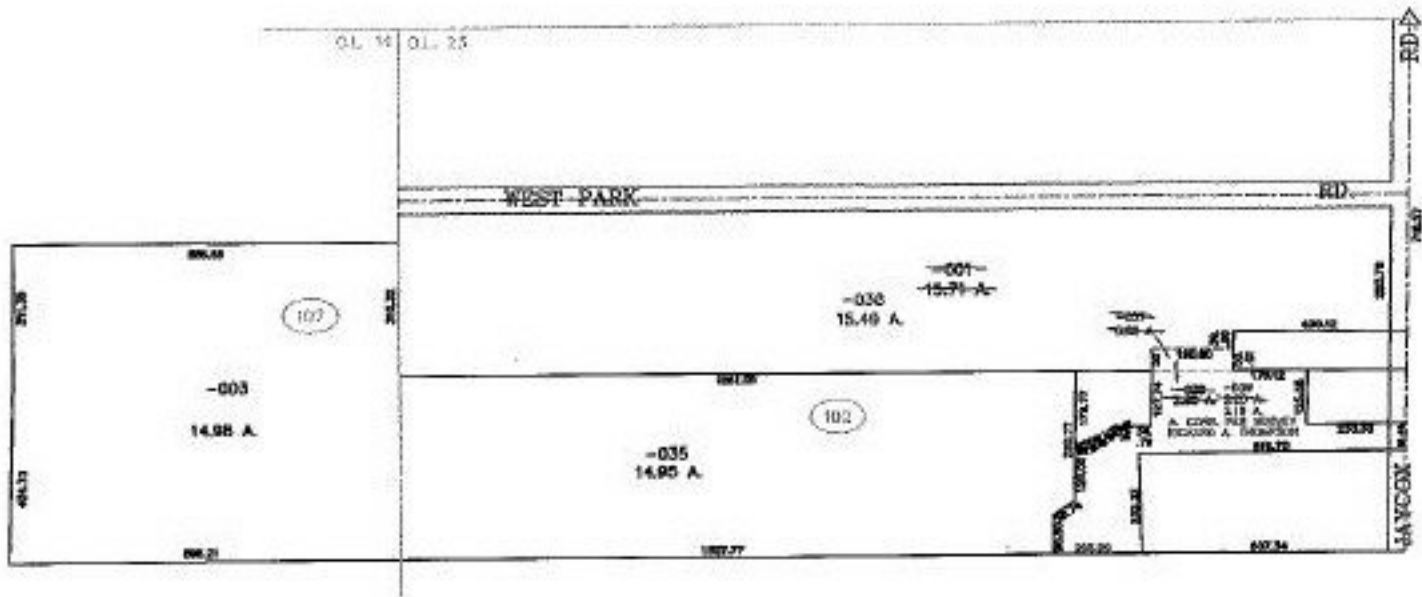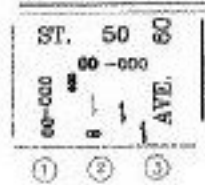

SPLITS/DEEDS PROCESSED

LORAIN COUNTY TAX MAP DEPARTMENT
226 MIDDLE AVE. ELYRIA, OHIO

SURVEYED BY: RICHARD A. THOMPSON

CLOSURE: 0.00 : 10.000

MAP PAGE(S): 04-00-023-A,B

APPROVED BY: JAH DATE: 7-16-02

SCALE: 1" = 500 PRIOR INSTRUMENT: 19990638788