

RASTER

PARENT PARCEL: 04-00-014-107-003



CHILD PARCEL: 04-00-014-107-221, -222

STARTING POINT: CENTERLINE OF JAYCOX RD. & O.L. 23

NO. 01140



PL0T 1" = 100'

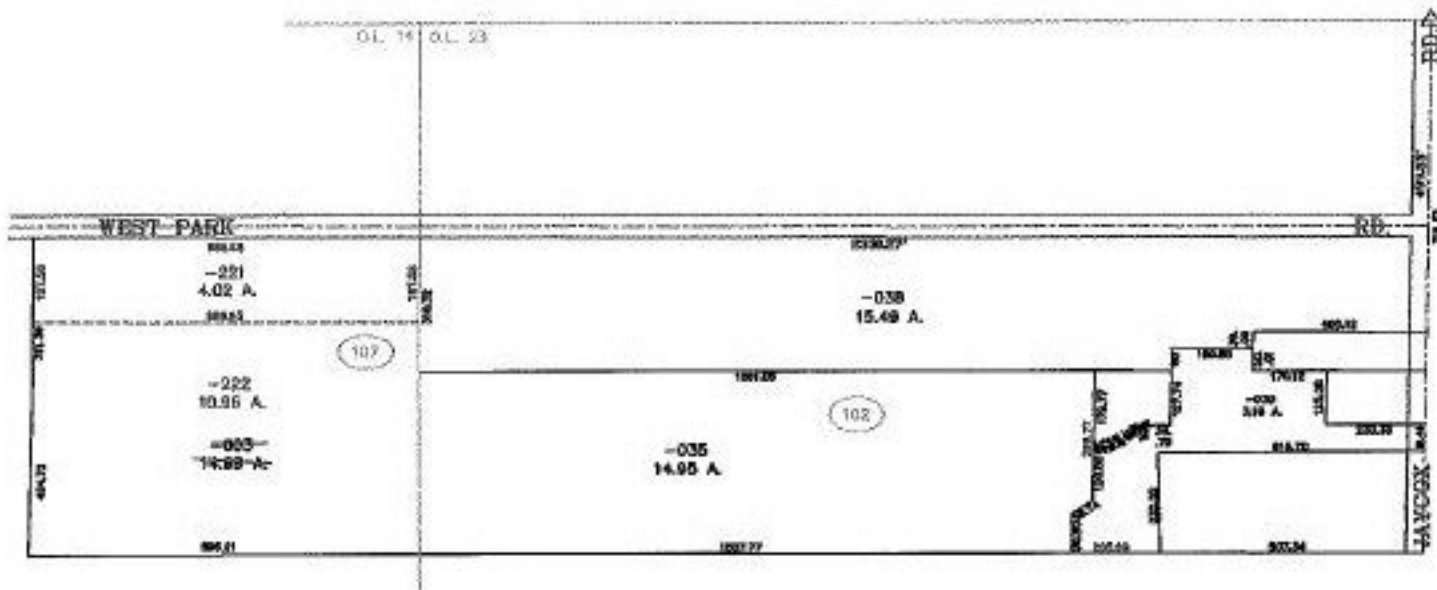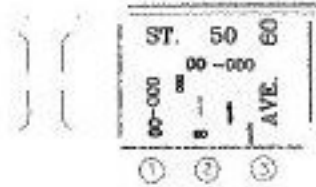

SPLITS/DEEDS PROCESSED

LORAIN COUNTY TAX MAP DEPARTMENT
226 MIDDLE AVE. ELYRIA, OHIO

SURVEYED BY: RICHARD A. THOMPSON

CLOSURE: 0.00 : 10.000

MAP PAGE(S): 04-00-014-D

APPROVED BY: JAH DATE: 7-16-02

SCALE: 1" = 500' PRIOR INSTRUMENT: 20020837027