


RASTER

PARENT PARCEL: 05-00-073-000-014, -021

CHILD PARCEL: 05-00-073-000-046

STARTING POINT: CENTERLINE OF ELYRIA-MILAN RD. & O.L. 73

NO. 01141

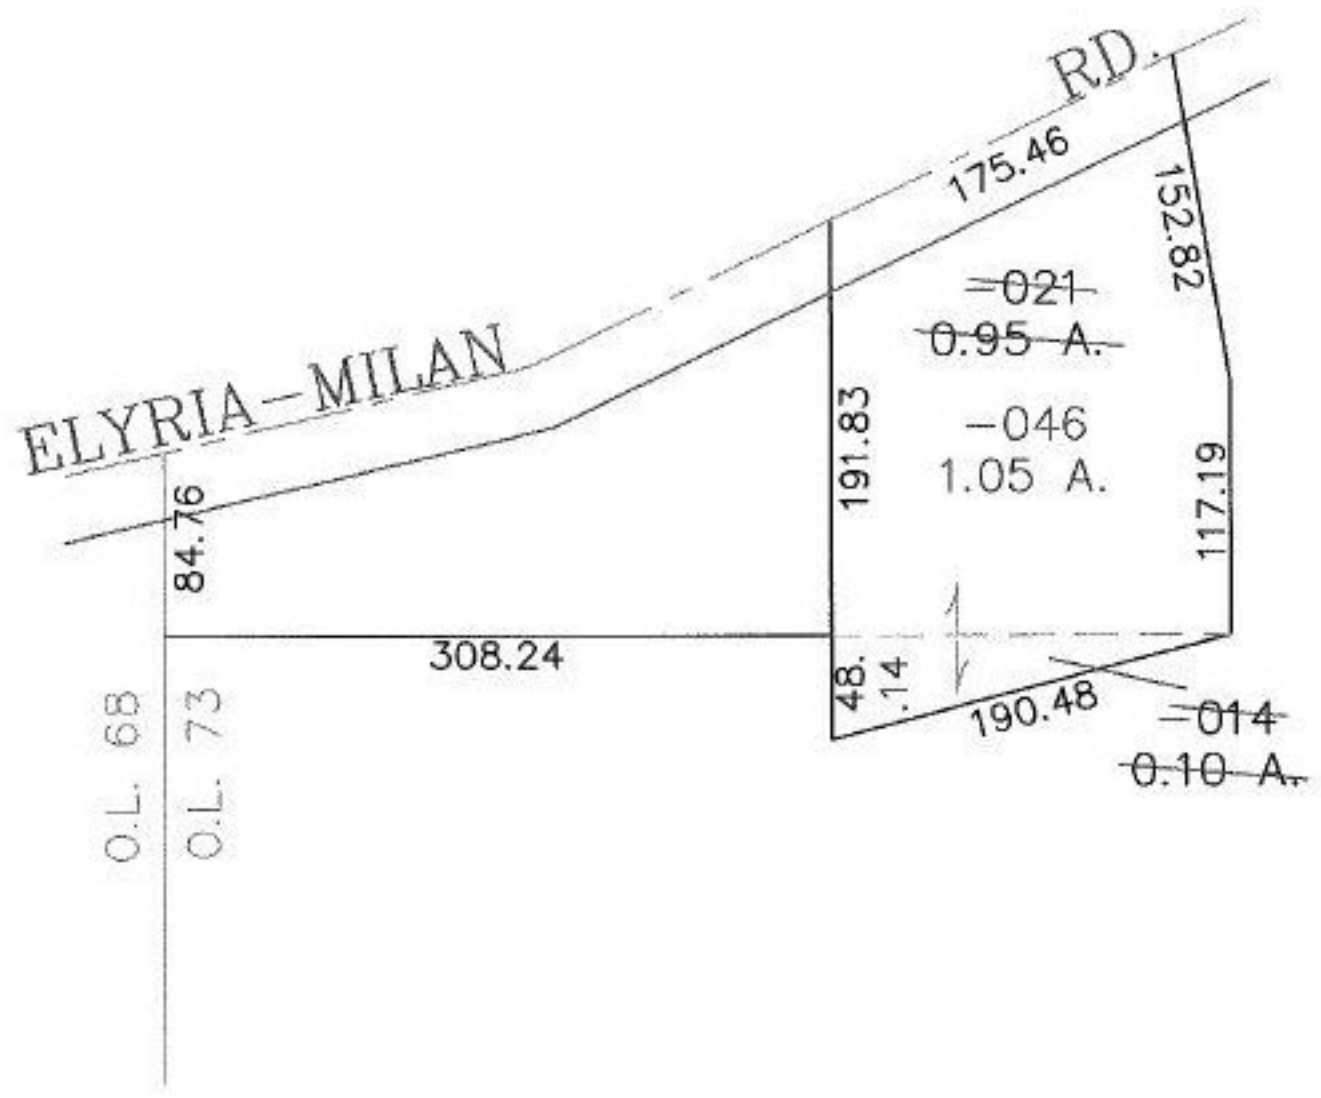

**SPLITS/DEEDS PROCESSED**

LORAIN COUNTY TAX MAP DEPARTMENT  
226 MIDDLE AVE. ELYRIA, OHIO

SURVEYED BY: CHARLES WARYU

CLOSURE: 0.00 : 10.000

MAP PAGE(S): 5-H

APPROVED BY: JAH DATE: 7-12-02

SCALE: 1" = 100' PRIOR INSTRUMENT: DV 1381/401