


RASTER

PARENT PARCEL: 01-00-044-000-017


CHILD PARCEL: 01-00-044-000-047, -048

STARTING POINT: CENTERLINE OF NORTH RIDGE RD. & CLAUS RD.

NO. 01142

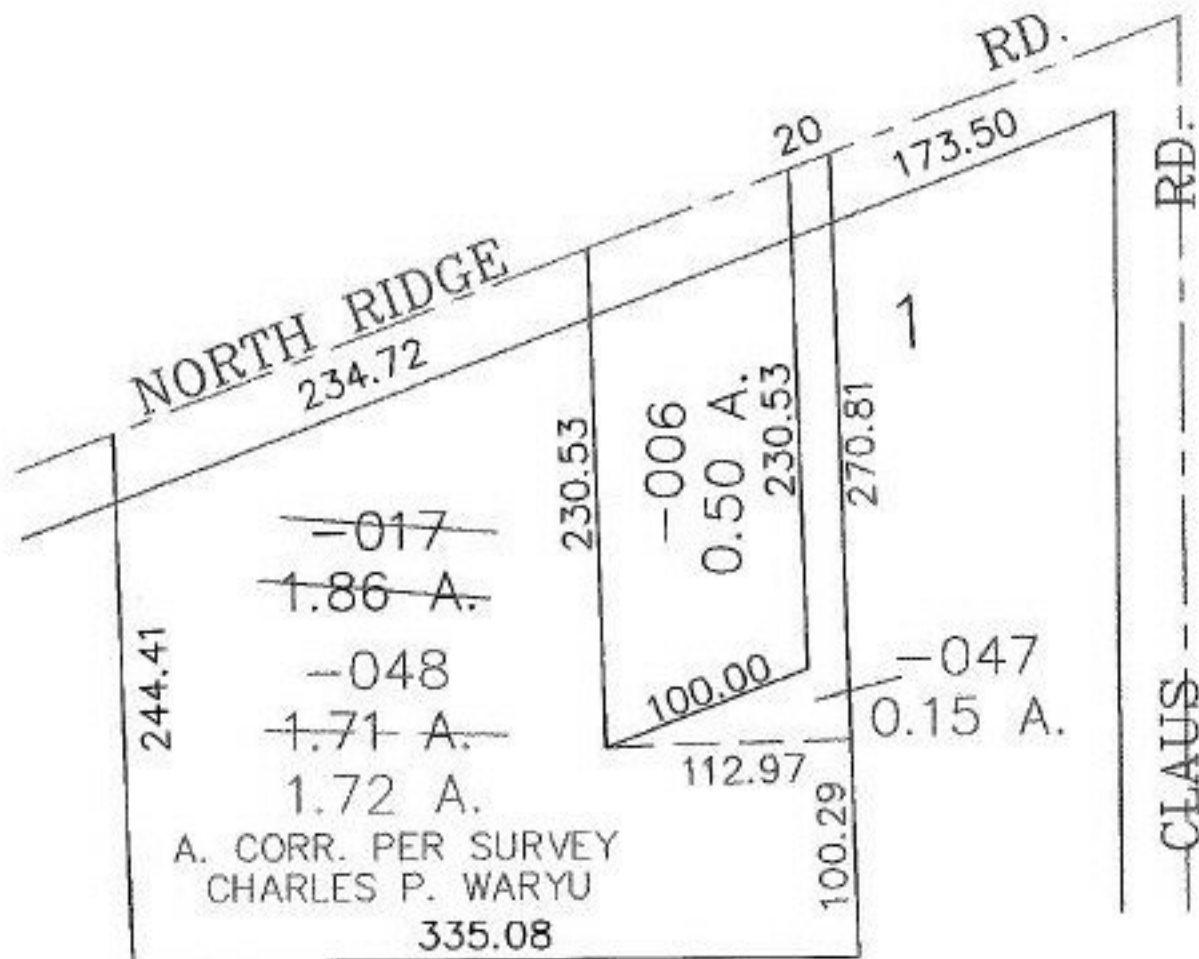

A. CORR. PER SURVEY
CHARLES P. WARYU
335.08

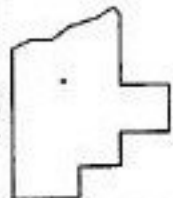

SPLITS/DEEDS PROCESSED

LORAIN COUNTY TAX MAP DEPARTMENT
226 MIDDLE AVE. ELYRIA, OHIO

SURVEYED BY: CHARLES P. WARYU

CLOSURE: 0.00 : 10.000

MAP PAGE(S): 1-00-044-B

APPROVED BY: JAH DATE: 7-16-02

SCALE: 1" = 100 PRIOR INSTRUMENT: 2002819319