
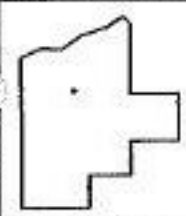
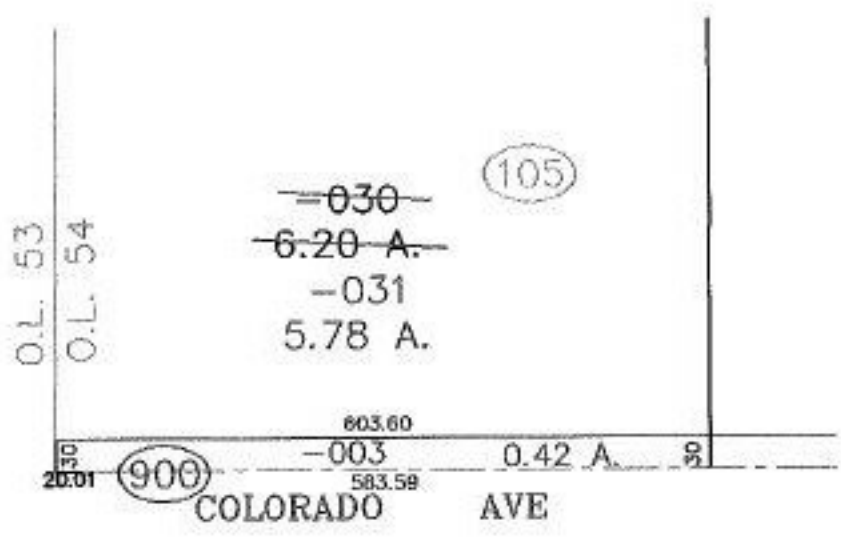


PARENT PARCEL: 03-00-054-105-030
CHILD PARCEL: 03-00-054-900-003, 03-00-054-105-031
STARTING POINT: CENTERLINE OF COLORADO AVE. & O.L. 54

NO. 01146

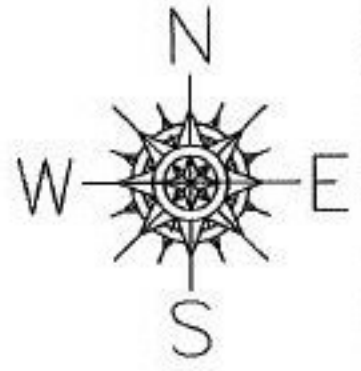

SPLITS/DEEDS PROCESSED
LORAIN COUNTY TAX MAP DEPARTMENT
226 MIDDLE AVE. ELYRIA, OHIO

SURVEYED BY: BRIAN P. MCARTNEY
CLOSURE: 0.00 : 10.000
MAP PAGE(S): 03-00-049-B
APPROVED BY: JAH DATE: 7-17-02
SCALE: 1" = 200' PRIOR INSTRUMENT: OR 1198/913