


PARENT PARCEL: 03-00-053-106-014

CHILD PARCEL: 03-00-053-900-004, 03-00-053-106-024

STARTING POINT: CENTERLINE OF COLORADO AVE. & O.L. 53

NO. 01149

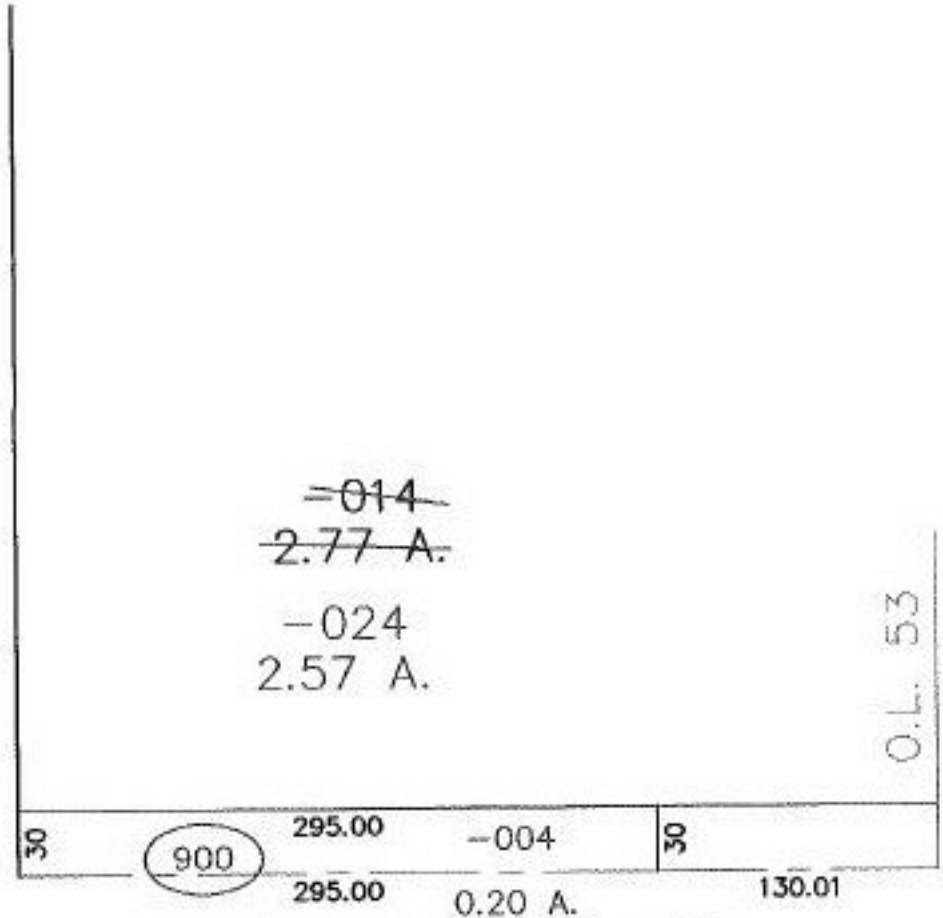

COLORADO AVE.



SPLITS/DEEDS PROCESSED

LORAIN COUNTY TAX MAP DEPARTMENT
226 MIDDLE AVE. ELYRIA, OHIO

SURVEYED BY: BRIAN P. MCCARTNEY
 CLOSURE: 0.00 : 10.000
 MAP PAGE(S): 03-00-053-A
 APPROVED BY: JAH DATE: 7-17-02
 SCALE: 1" = 100 PRIOR INSTRUMENT: OR 1198/913