


RASTER

PARENT PARCEL: 03-00-058-102-018

CHILD PARCEL: 03-00-058-900-004, 03-00-058-102-020

STARTING POINT: CENTERLINE OF COLORADO AVE. & O.L. 58

NO. 01151

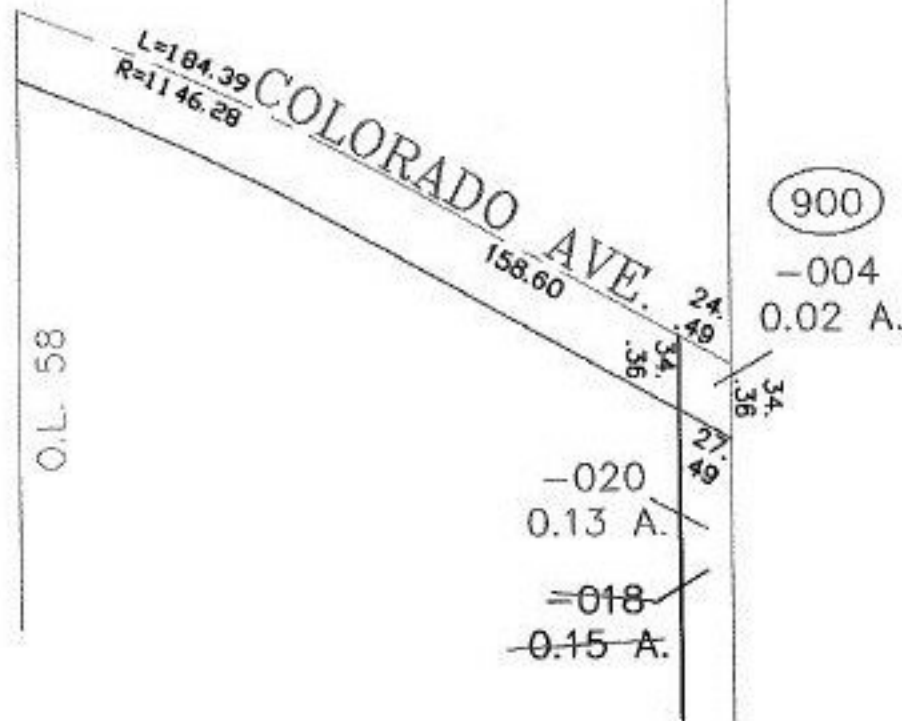

SPLITS/DEEDS PROCESSED

LORAIN COUNTY TAX MAP DEPARTMENT
226 MIDDLE AVE. ELYRIA, OHIO

SURVEYED BY: BRIAN P. MCCARTNEY

CLOSURE: 0.00 : 10.000

MAP PAGE(S): 03-00-058-A

APPROVED BY: JAH DATE: 7-17-02

SCALE: 1" = 100' PRIOR INSTRUMENT: DV 367/215