
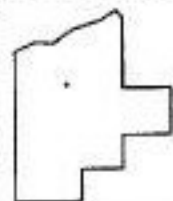


PARENT PARCEL: 15-00-033-000-014, -002

CHILD PARCEL: 15-00-033-000-017, -018

STARTING POINT: CENTERLINE OF BIGGS RD. & WHEELER RD.

NO. 01155

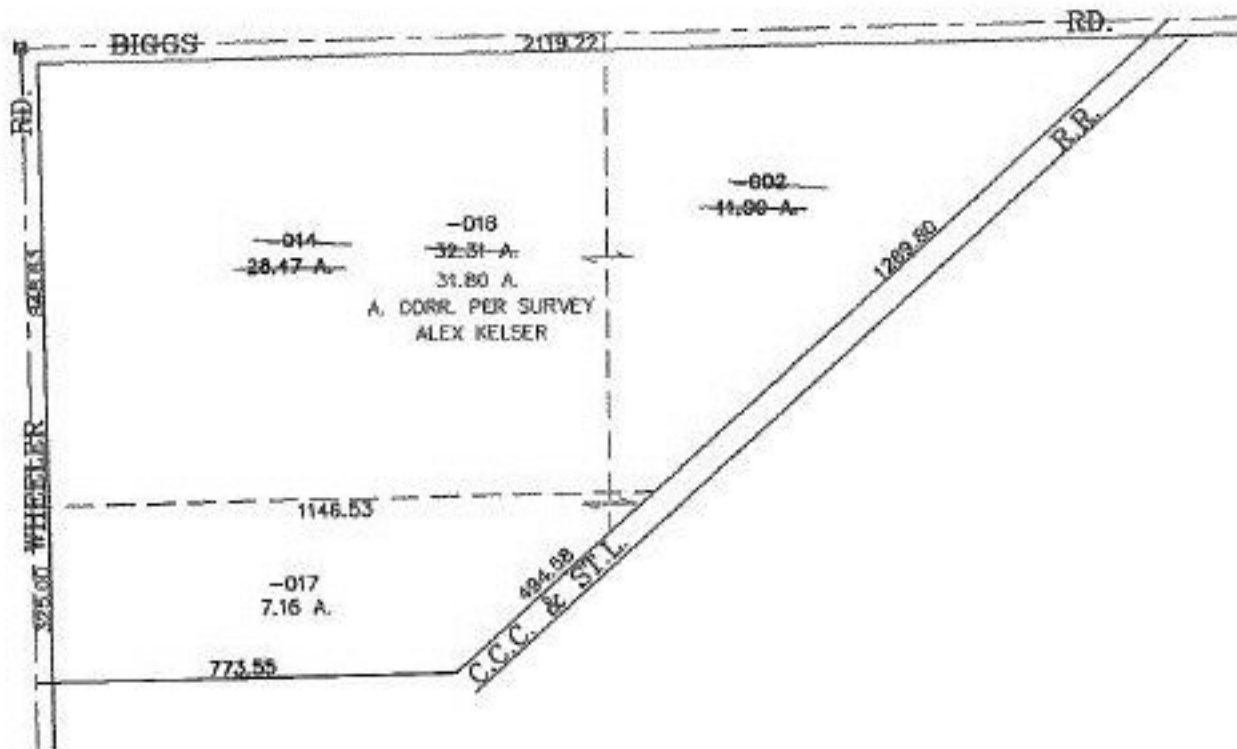

SPLITS/DEEDS PROCESSED
 LORAIN COUNTY TAX MAP DEPARTMENT
 226 MIDDLE AVE. ELYRIA, OHIO

SURVEYED BY: ALEX KELSER
 CLOSURE: 0.00 : 10.000
 MAP PAGE(S): 15-00-033-A
 APPROVED BY: JAH DATE: 7-22-02
 SCALE: 1" = 400' PRIOR INSTRUMENT: 20020833944