
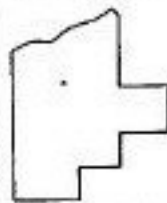


RASER

PARENT PARCEL: 03-00-001-000-132, -127
CHILD PARCEL: 03-00-001-000-141, -142
STARTING POINT: CENTERLINE OF DETROIT RD. & ABBE RD.

NO. 01160

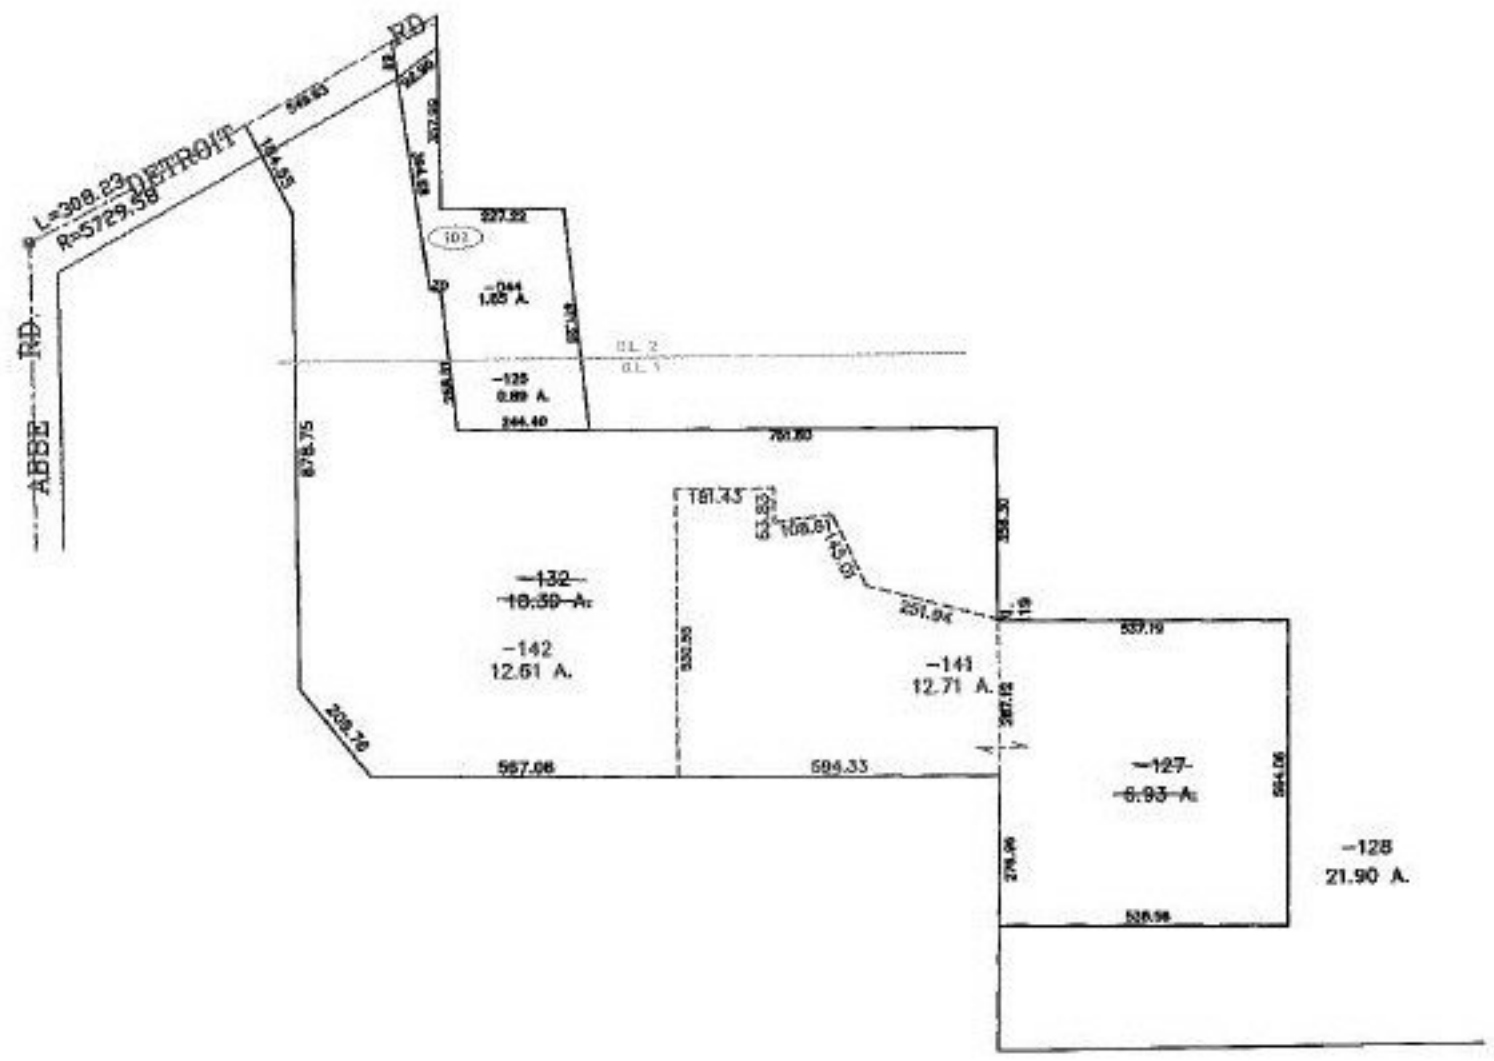

SPLITS/DEEDS PROCESSED
LORAIN COUNTY TAX MAP DEPARTMENT
226 MIDDLE AVE. ELYRIA, OHIO

SURVEYED BY: RAYMOND W. FOOS
CLOSURE: 0.00 : 10.000
MAP PAGE(S): 3-00-001-A, B
APPROVED BY: JAH DATE: 7-25-02
SCALE: 1" = 400' PRIOR INSTRUMENT: OR 1438/745