


PARENT PARCEL: 10-00-012-000-122

CHILD PARCEL: 10-00-012-000-168, -169

STARTING POINT: CENTERLINE OF BUTTERNUT RIDGE RD. & OBERLIN-ELYRIA RD.

NO. 01164

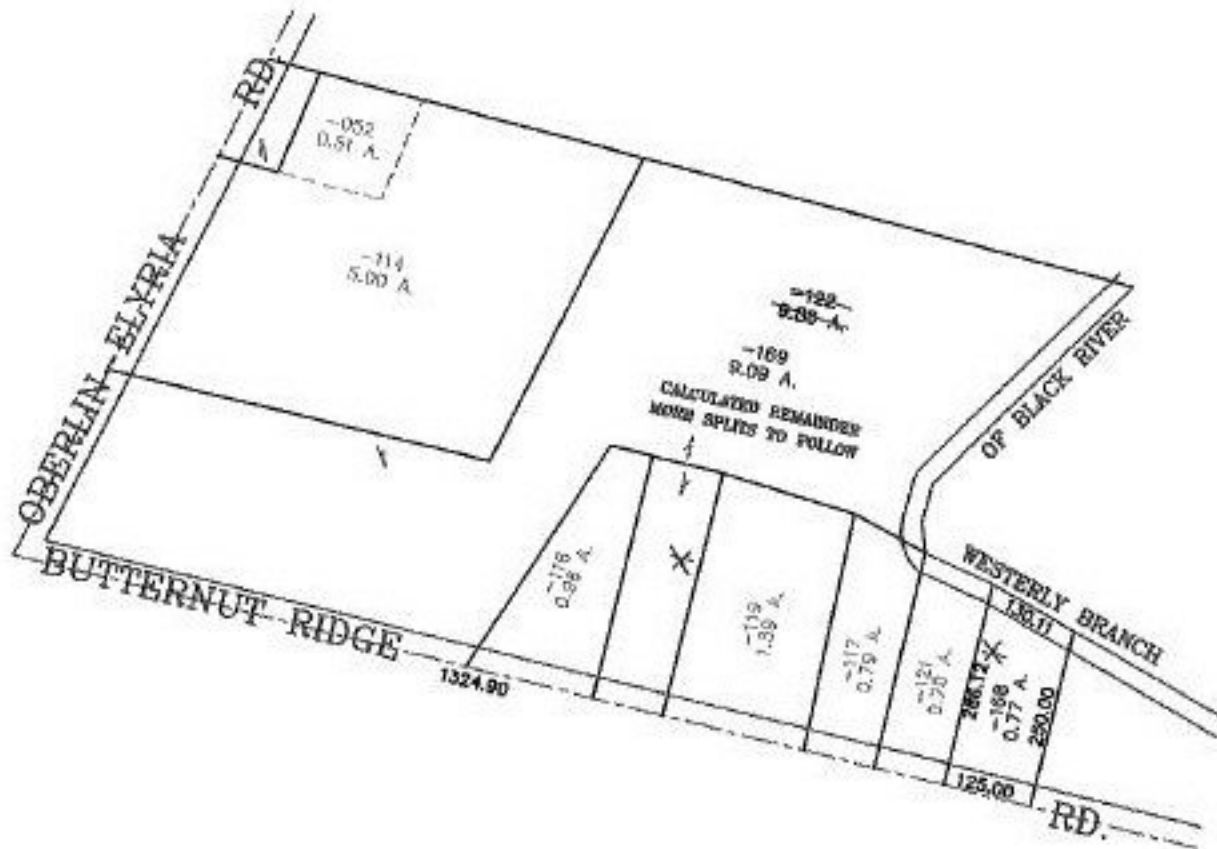

SPLITS/DEEDS PROCESSED
 LORAIN COUNTY TAX MAP DEPARTMENT
 226 MIDDLE AVE. ELYRIA, OHIO

SURVEYED BY: RODGER G. SIMON
 CLOSURE: 0.00 : 10.000
 MAP PAGE(S): 10-00-012-B
 APPROVED BY: JAH DATE: 7-31-02
 SCALE: 1" = 300 PRIOR INSTRUMENT: OR 196/710