


PARENT PARCEL: 09-00-025-000-011


CHILD PARCEL: 09-00-025-000-012, -013

STARTING POINT: CENTERLINE OF RUSSIA RD. & O.L. 25

NO. 01169

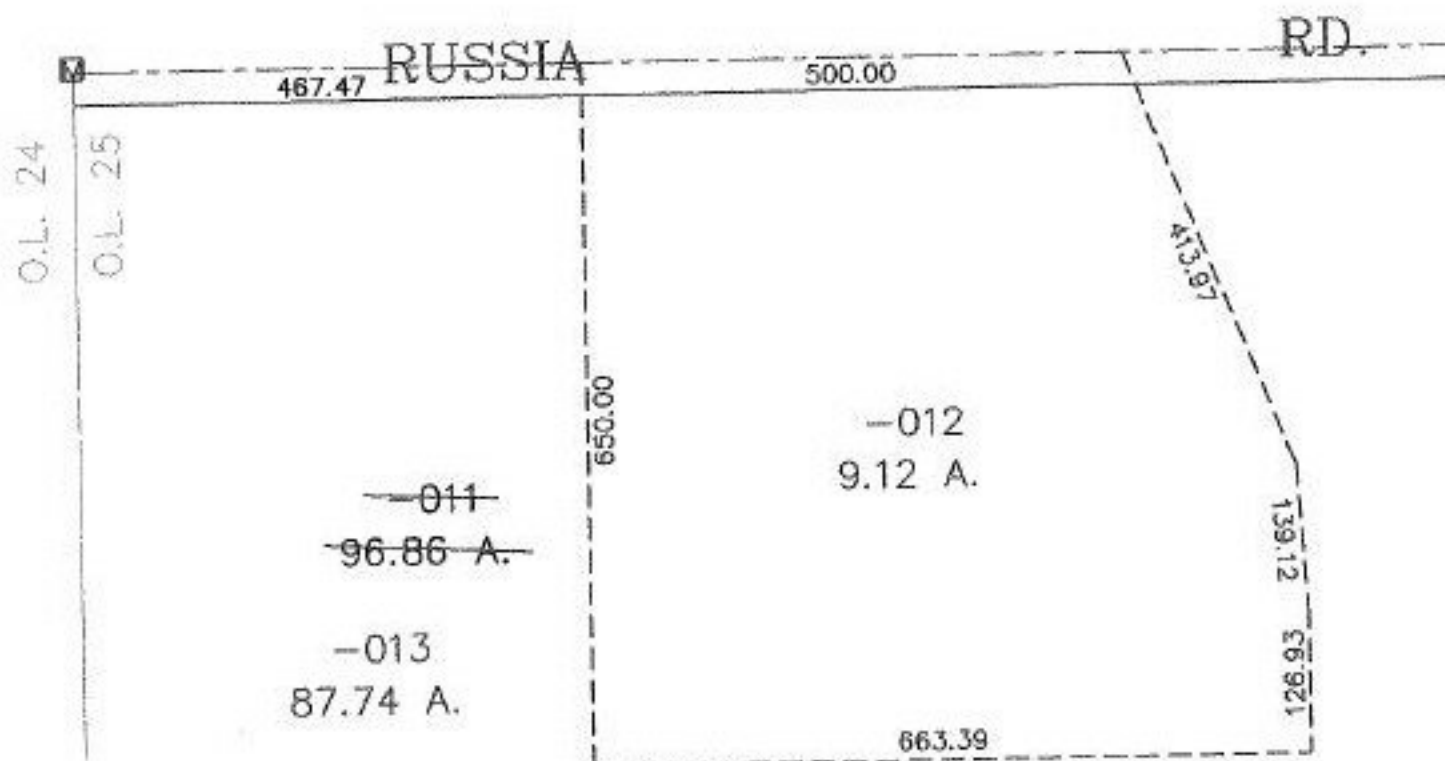

SURVEYED BY: THOMAS A. SIMON  
 CLOSURE: 0.00 : 10,000  
 MAP PAGE(S): 9-B  
 APPROVED BY: JAH DATE: 8-1-02  
 SCALE: 1" = 200' PRIOR INSTRUMENT: OR 1362/516

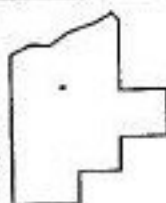

**SPLITS/DEEDS PROCESSED**  
 LORAIN COUNTY TAX MAP DEPARTMENT  
 226 MIDDLE AVE. ELYRIA, OHIO