


PARENT PARCEL: 05-00-078-000-008, -009

CHILD PARCEL: 05-00-078-000-042

STARTING POINT: CENTERLINE OF MIDDLE RIDGE RD. & O.L. 78

NO. 01175

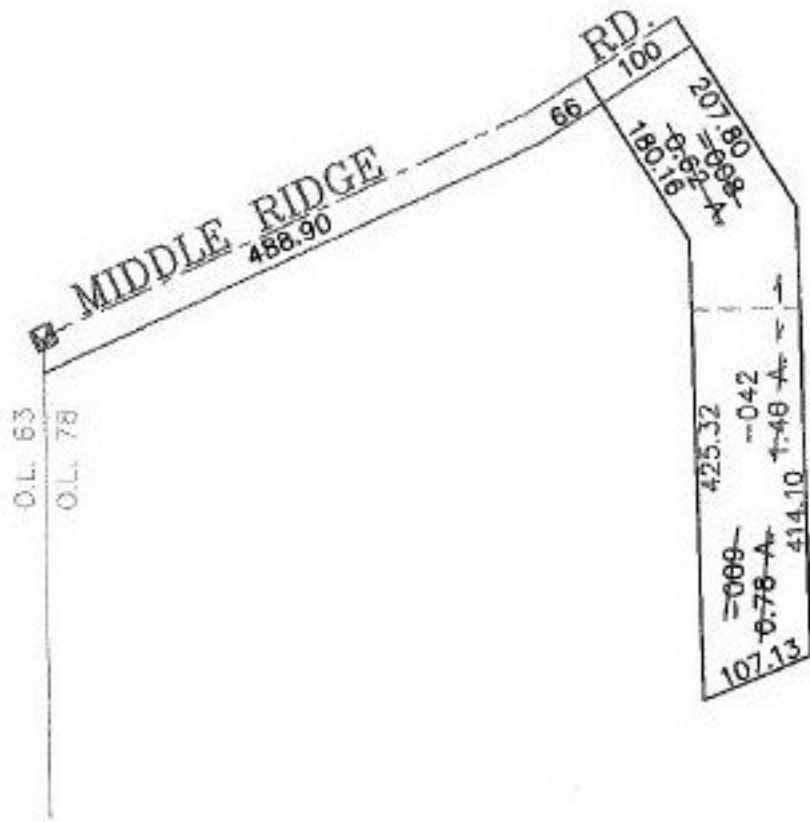

A. CORR. PER SURVEY  
JOHN POZYWAK



**SPLITS/DEEDS PROCESSED**  
LORAIN COUNTY TAX MAP DEPARTMENT  
226 MIDDLE AVE. ELYRIA, OHIO

SURVEYED BY: JOHN POZYWAK  
CLOSURE: 0.00 : 10.000  
MAP PAGE(S): 5-00-078-A  
APPROVED BY: JAH DATE: 8-9-02  
SCALE: 1" = 200' PRIOR INSTRUMENT: 20000702592