


RASTER

NO. 01179

PARENT PARCEL: 05-00-016-101-007, 05-00-005-106-005, -006

CHILD PARCEL: 05-00-016-101-007, 05-00-005-106-016

STARTING POINT: CENTERLINE OF SOUTH LAKE ST. & WILLOW CREEK DR.

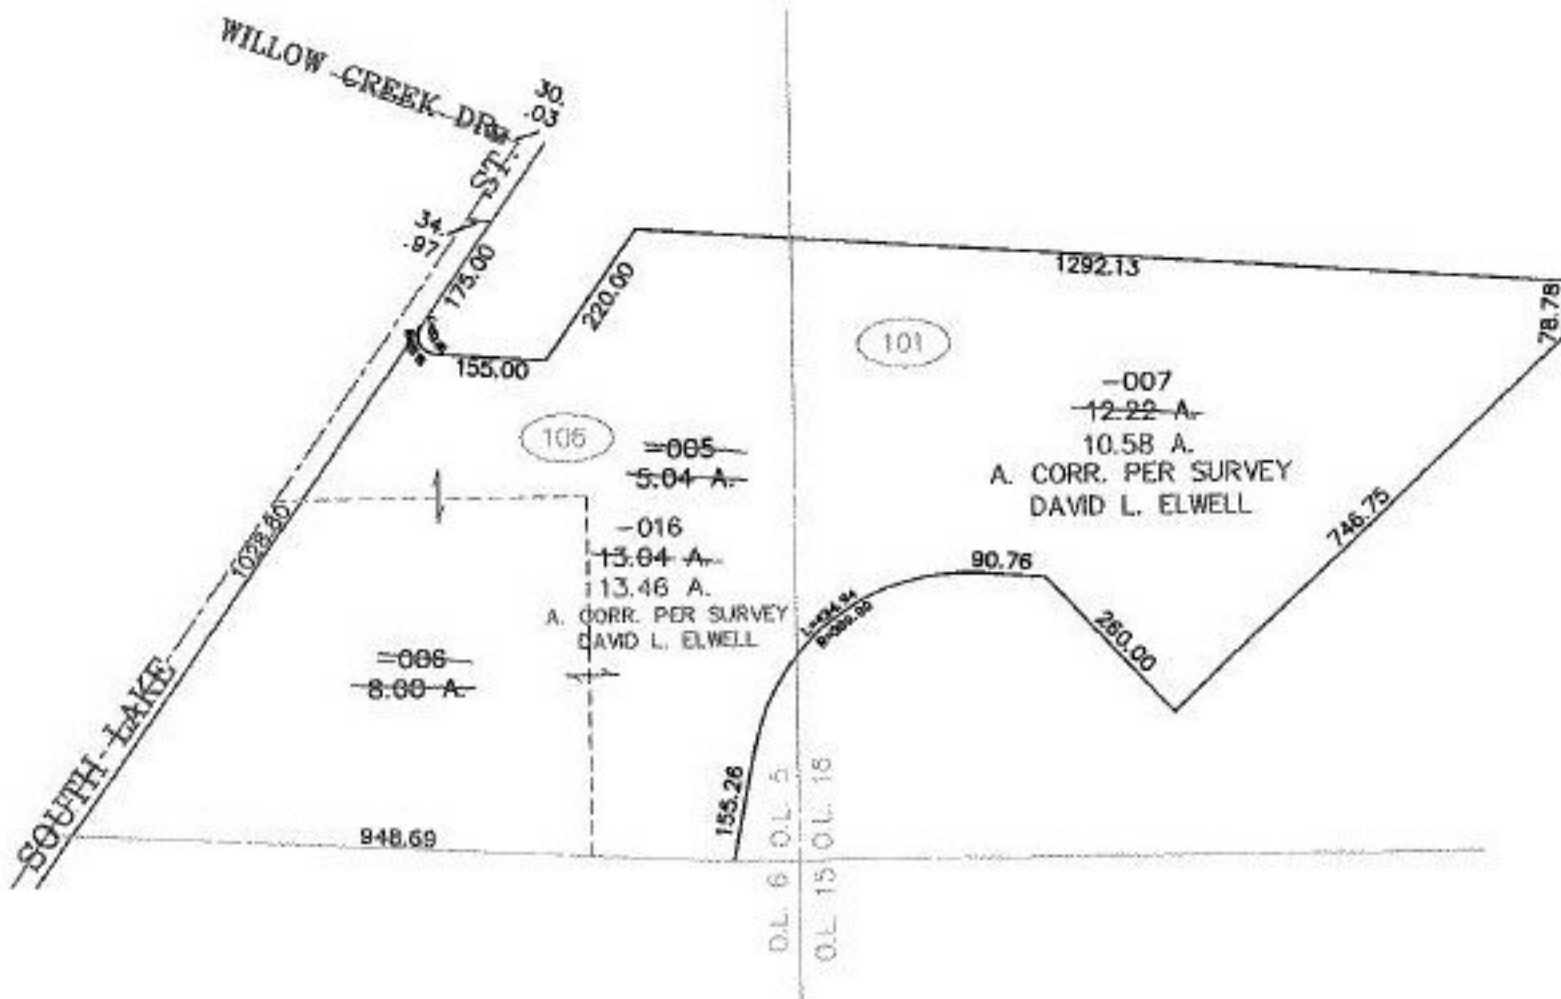

SPLITS/DEEDS PROCESSED
LORAIN COUNTY TAX MAP DEPARTMENT
 226 MIDDLE AVE. ELYRIA, OHIO

SURVEYED BY: DAVID L. ELWELL
 CLOSURE: 0.00 : 10.000
 MAP PAGE(S): 5-00-005-B, 05-00-016-A
 APPROVED BY: JAH DATE: 8-19-02
 SCALE: 1" = 300' PRIOR INSTRUMENT: 20010787528