



FASTER

PARENT PARCEL: 05-00-099-000-111

CHILD PARCEL: 05-00-099-000-173, -174

STARTING POINT: CENTERLINE OF QUARRY RD. & S.R. 2

NO. 01184

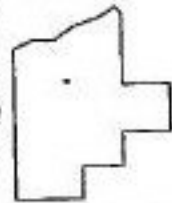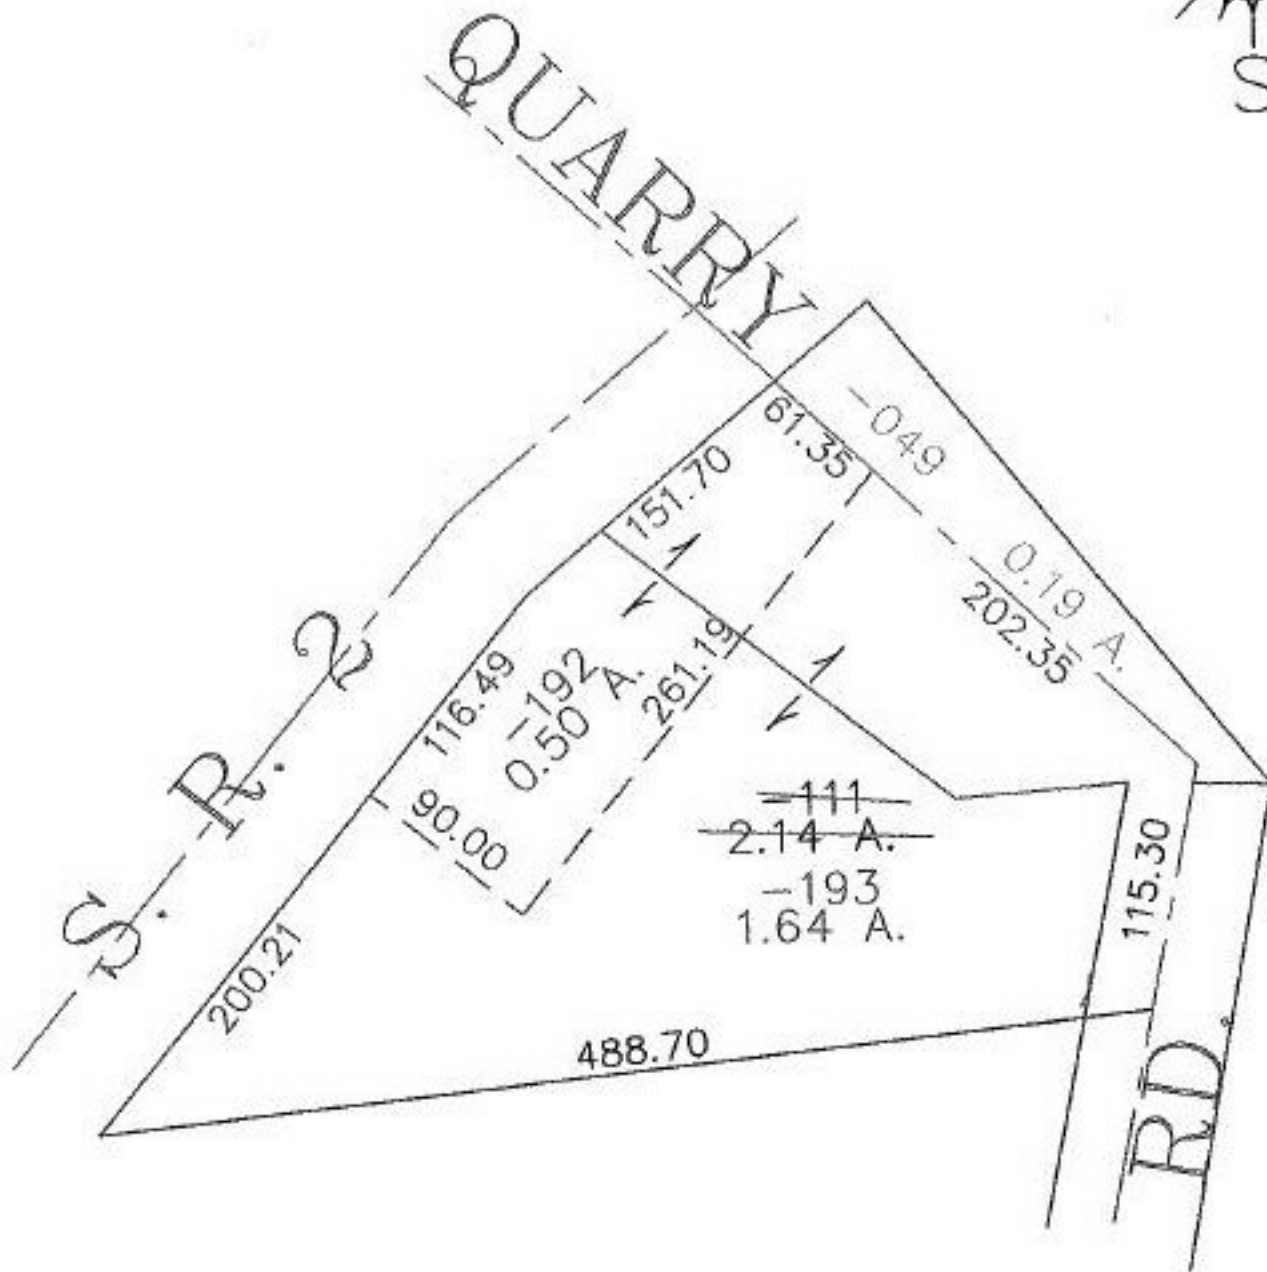

**SPLITS/DEEDS PROCESSED**

LORAIN COUNTY TAX MAP DEPARTMENT  
226 MIDDLE AVE. ELYRIA, OHIO

SURVEYED BY: PHILIP A ROSEBECK

CLOSURE: 0.00 : 10.000

MAP PAGE(S): 5-00-099-C

APPROVED BY: JAH DATE: 8-20-02

SCALE: 1" = 100' PRIOR INSTRUMENT: OR 1281/629