


PASTER

PARENT PARCEL: 13-09-029-000-006, -004
CHILD PARCEL: 13-09-029-000-011 THRU -013
STARTING POINT: CENTERLINE OF ROWELL RD. & O.L. 29

NO. 01186



~~-006~~
~~47.75 A.~~
-012
47.50 A.

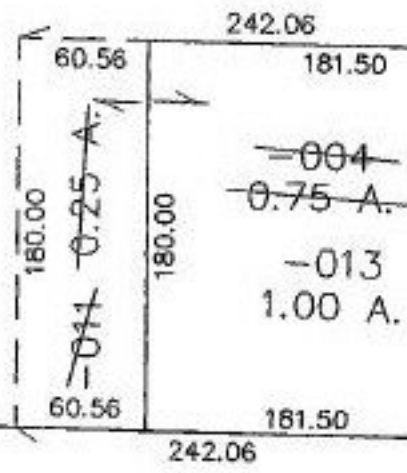


~~-004~~
~~0.75 A.~~
-013
1.00 A.

RD.

751.00

ROWELL

O.L. 29
O.L. 44

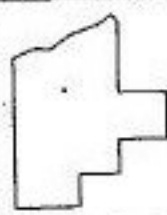

SPLITS/DEEDS PROCESSED

LORAIN COUNTY TAX MAP DEPARTMENT
226 MIDDLE AVE. ELYRIA, OHIO

SURVEYED BY: JOHN POZYWAK
CLOSURE: 0.00 : 10.000
MAP PAGE(S): 13-H
APPROVED BY: JAH DATE: 8-22-02
SCALE: 1" = 100' PRIOR INSTRUMENT: OR 437/310