


PARENT PARCEL: 02-03-001-108-038

CHILD PARCEL: 02-03-001-108-039 & -040

STARTING POINT: SOUTHEAST CORNER OF S/L 18 OF THE KOLBE ACRES SUBD.

NO. 01189

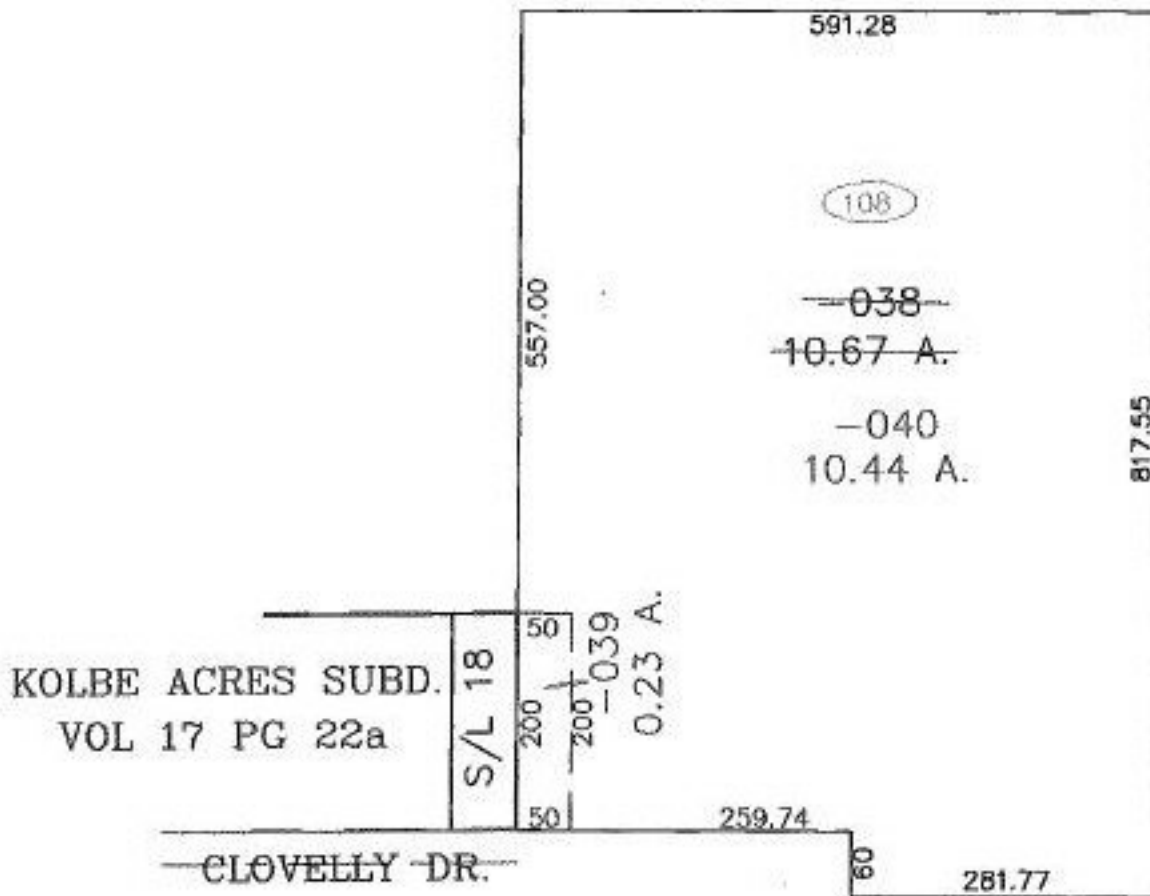

SPLITS/DEEDS PROCESSED
LORAIN COUNTY TAX MAP DEPARTMENT
 226 MIDDLE AVE. ELYRIA, OHIO

SURVEYED BY: PATRICK A. MCGANNON
 CLOSURE: 0.00 : 10,000
 MAP PAGE(S): 2-F
 APPROVED BY: JAH DATE: 8-28-02
 SCALE: 1" = 200 PRIOR INSTRUMENT: 20020837025