



RASTER

PARENT PARCEL: 05-00-079-000-086

CHILD PARCEL: 05-00-079-000-089, -090

STARTING POINT: CENTERLINE OF MIDDLE RIDGE RD. & O.L. 79

NO. 01191

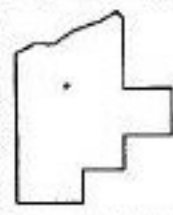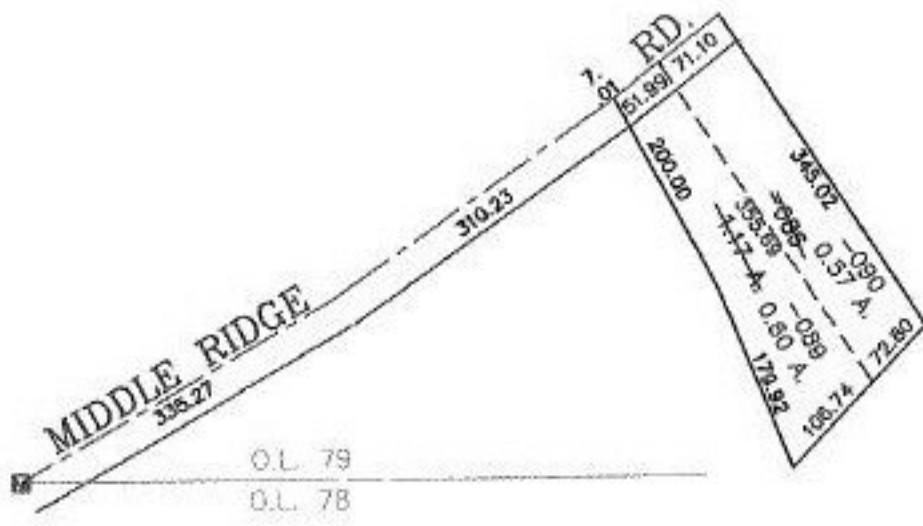

**SPLITS/DEEDS PROCESSED**  
 LORAIN COUNTY TAX MAP DEPARTMENT  
 226 MIDDLE AVE. ELYRIA, OHIO

SURVEYED BY: THOMAS SIMON  
 CLOSURE: 0.00 : 10.000  
 MAP PAGE(S): 5-00-079-B  
 APPROVED BY: JAH DATE: 8-28-02  
 SCALE: 1" = 200' PRIOR INSTRUMENT: 20010736645