
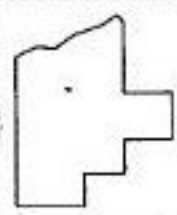


MASTER

PARENT PARCEL: 04-00-012-103-032, -033, -034, -131
CHILD PARCEL: 04-00-012-103-249 THRU -251
STARTING POINT: CENTERLINE OF STONEYRIDGE RD. & LONG RD.

NO. 01195

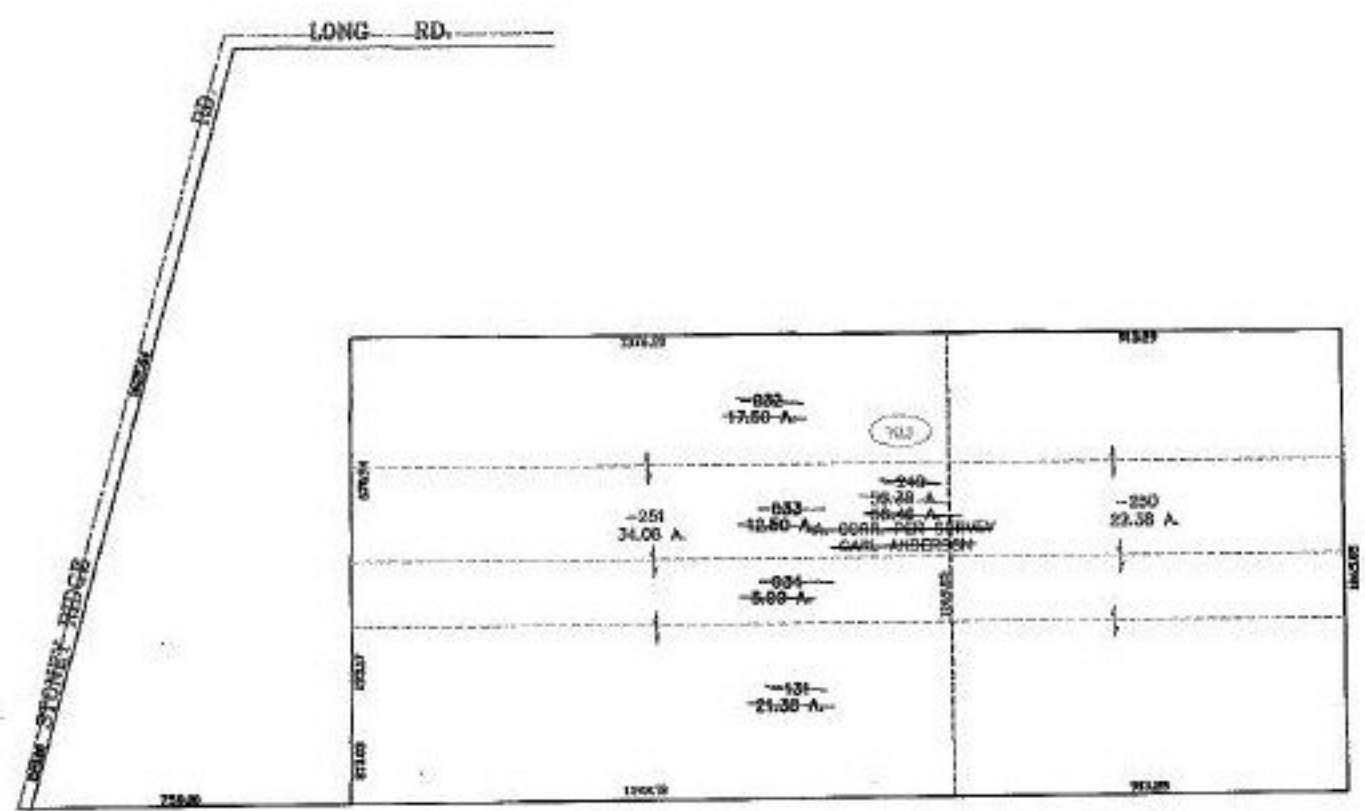

SPLITS/DEEDS PROCESSED
LORAIN COUNTY TAX MAP DEPARTMENT
226 MIDDLE AVE. ELYRIA, OHIO

SURVEYED BY: CARL ANDERSON
CLOSURE: 0.00 : 10.000
MAP PAGE(S): 12-C
APPROVED BY: JAH DATE: 9-3-02
SCALE: 1" = 500' PRIOR INSTRUMENT: 20020814440