



MASTER

PARENT PARCEL: 07-00-001-000-020, -029

CHILD PARCEL: 07-00-001-000-159, -160

STARTING POINT: CENTERLINE OF SPRAGUE RD. & O.L. 1

NO. 01202

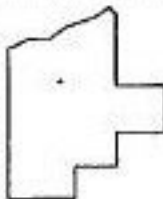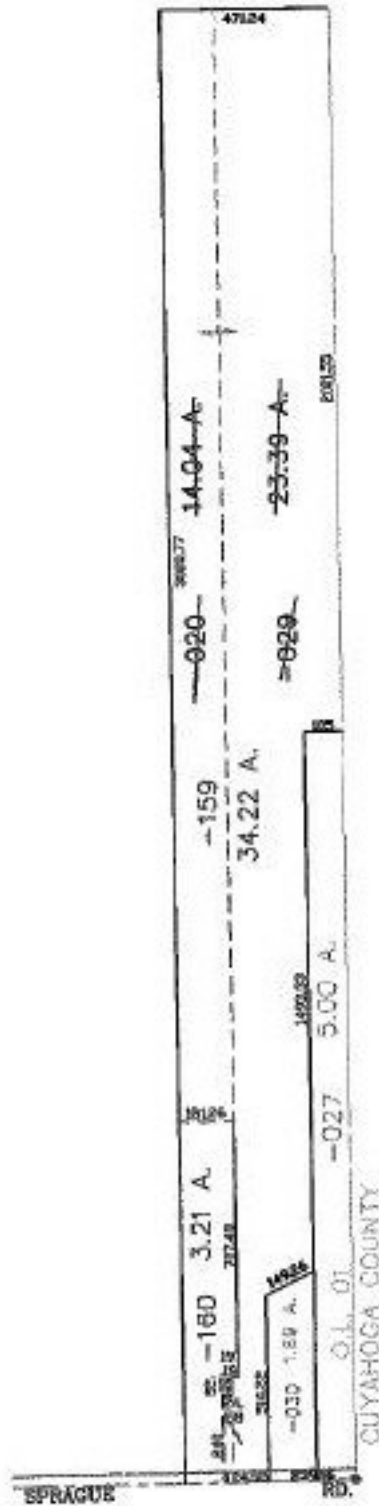

SPLITS/DEEDS PROCESSED

LORAIN COUNTY TAX MAP DEPARTMENT
226 MIDDLE AVE. ELYRIA, OHIO

SURVEYED BY: RICHARD ROY MACKAY

CLOSURE: 0.00 : 10.000

MAP PAGE(S): 7-H

APPROVED BY: JAH DATE: 9-12-02

SCALE: 1" = 600' PRIOR INSTRUMENT: DV 1172/11