


EASTER

PARENT PARCEL: 01-00-080-000-013, 01-20-026-000-046

CHILD PARCEL: SAME

STARTING POINT: CENTERLINE OF SPERRY RD. & DEAN RD.

NO. 01205

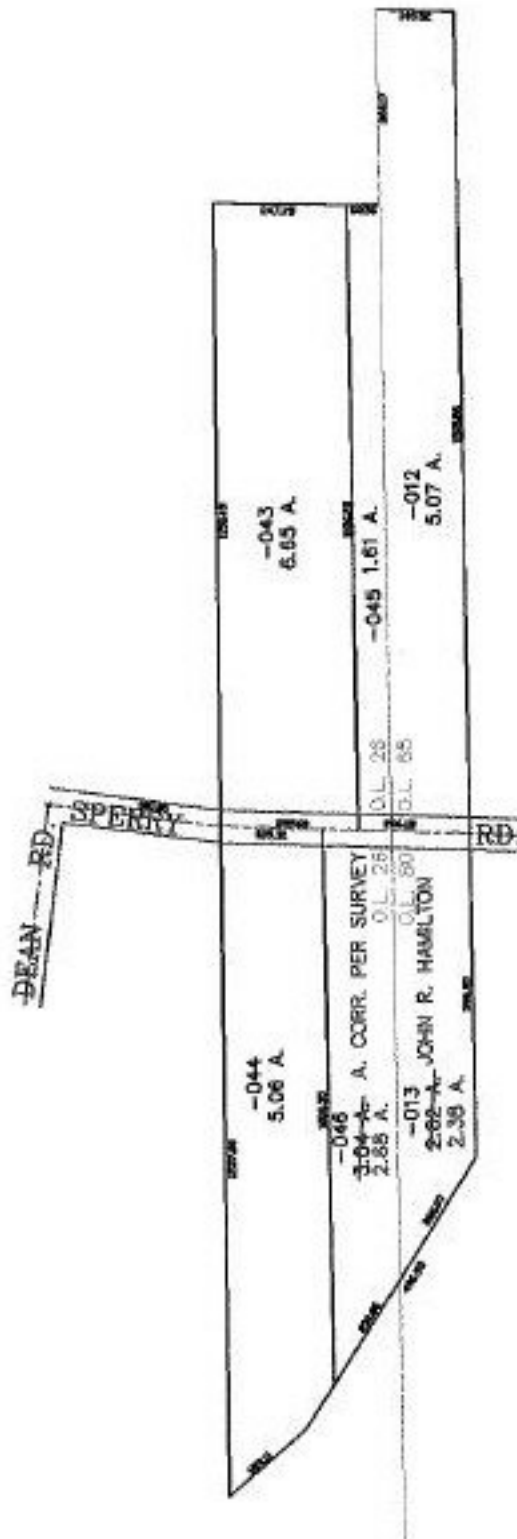

SPLITS/DEEDS PROCESSED
LORAIN COUNTY TAX MAP DEPARTMENT
226 MIDDLE AVE. ELYRIA, OHIO

SURVEYED BY: M.G. HURA/JOHN HAMILTON
CLOSURE: 0.00 : 10,000
MAP PAGE(S): 1-1
APPROVED BY: JAH DATE: 9-18-02
SCALE: 1" = 400' PRIOR INSTRUMENT: 20010771986