


PARENT PARCEL: 02-02-011-000-021, 02-02-012-101-005

CHILD PARCEL: 02-02-011-000-066 THRU -069 02-02-012-101-011, -012

STARTING POINT: CENTERLINE OF MEISTER RD. & O.L. 11 & 12

NO. 01207

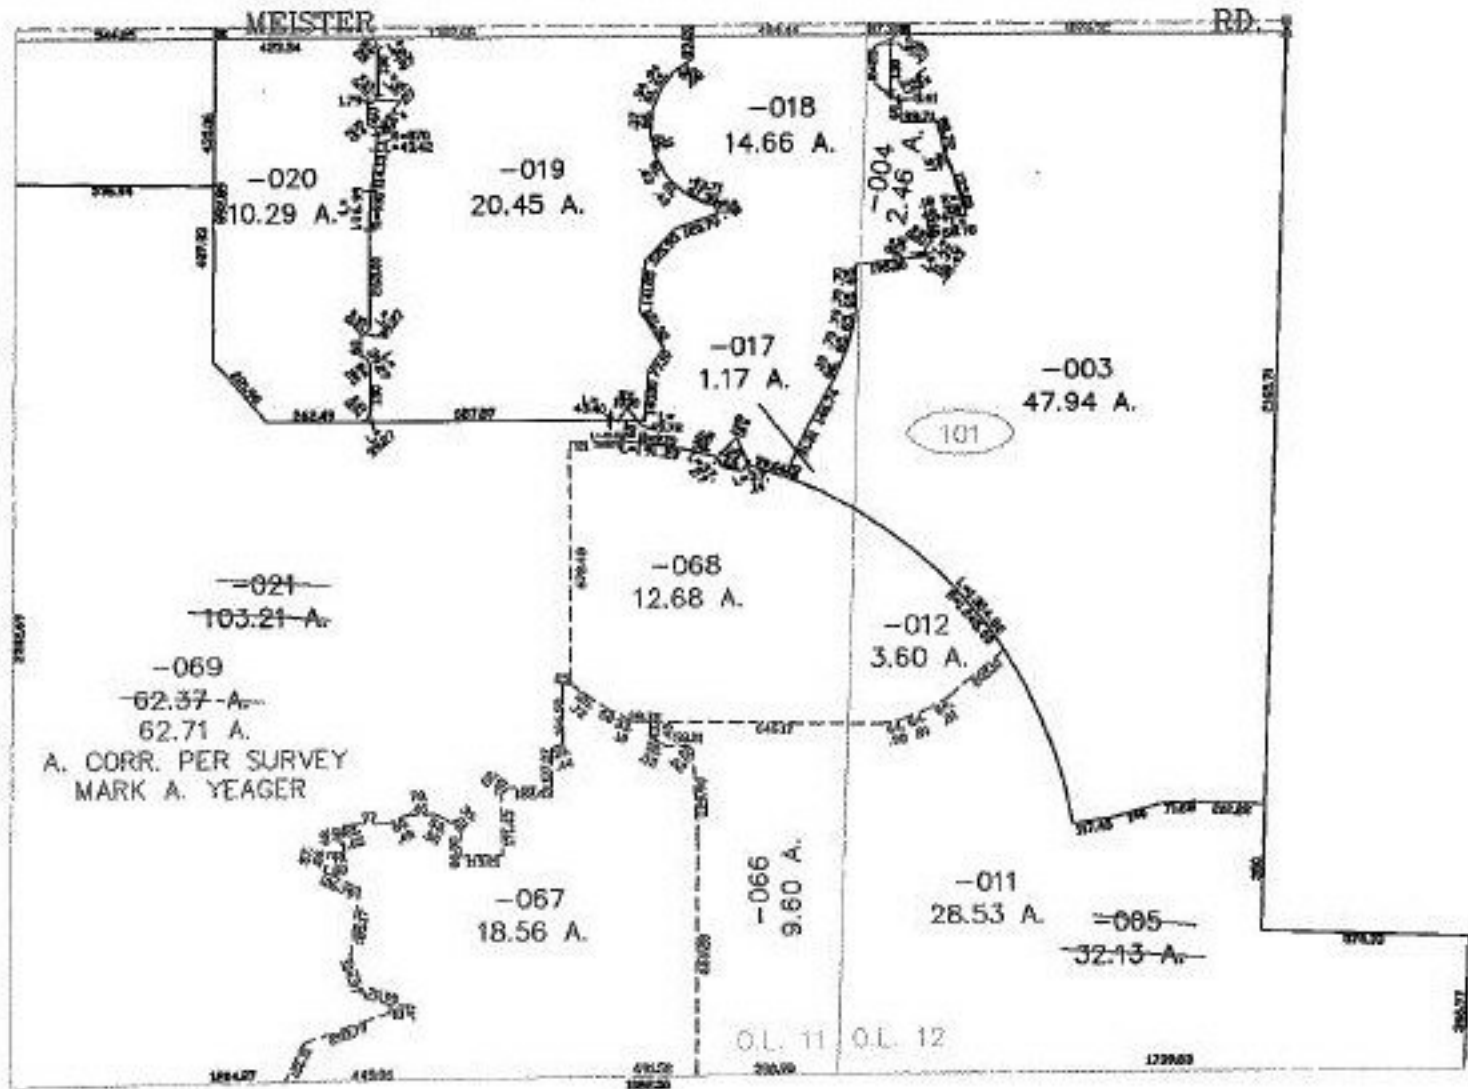

SPLITS/DEEDS PROCESSED

LORAIN COUNTY TAX MAP DEPARTMENT
226 MIDDLE AVE. ELYRIA, OHIO

SURVEYED BY: MARK ALLEN YEAGER

CLOSURE: 0.01 : 10,000

MAP PAGE(S): 2-F

APPROVED BY: JAH DATE: 09-20-02

SCALE: 1" = 600 PRIOR INSTRUMENT: 20010729273