



RASTER

PARENT PARCEL: 03-00-055-121-015, -016
CHILD PARCEL: 03-00-055-121-022 THRU -025
STARTING POINT: CENTERLINE OF COLORADO AVE. & O.L. 55

NO. 01210



COLORADO AVE.

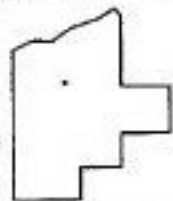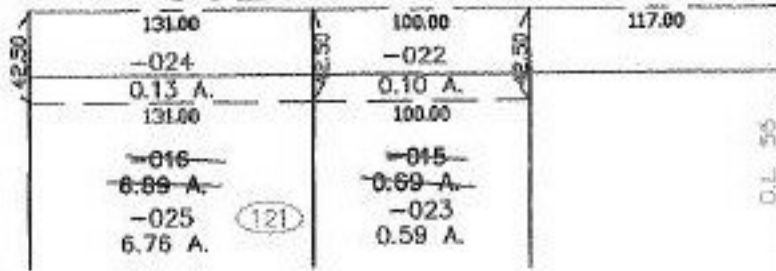

SPLITS/DEEDS PROCESSED
LORAIN COUNTY TAX MAP DEPARTMENT
226 MIDDLE AVE. ELYRIA, OHIO

SURVEYED BY: BRIAN P. MCCARTNEY
CLOSURE: 0.00 : 10.000
MAP PAGE(S): 03-00-055-A
APPROVED BY: JAH DATE: 9-23-02
SCALE: 1" = 100' PRIOR INSTRUMENT: DV 224/102