


RASTER

PARENT PARCEL: 04-00-027-101-047 & 04-00-028-102-063
CHILD PARCEL: 04-00-027-101-056 & -057 , 04-00-028-102-094
STARTING POINT: XXXXXX

NO. 01212

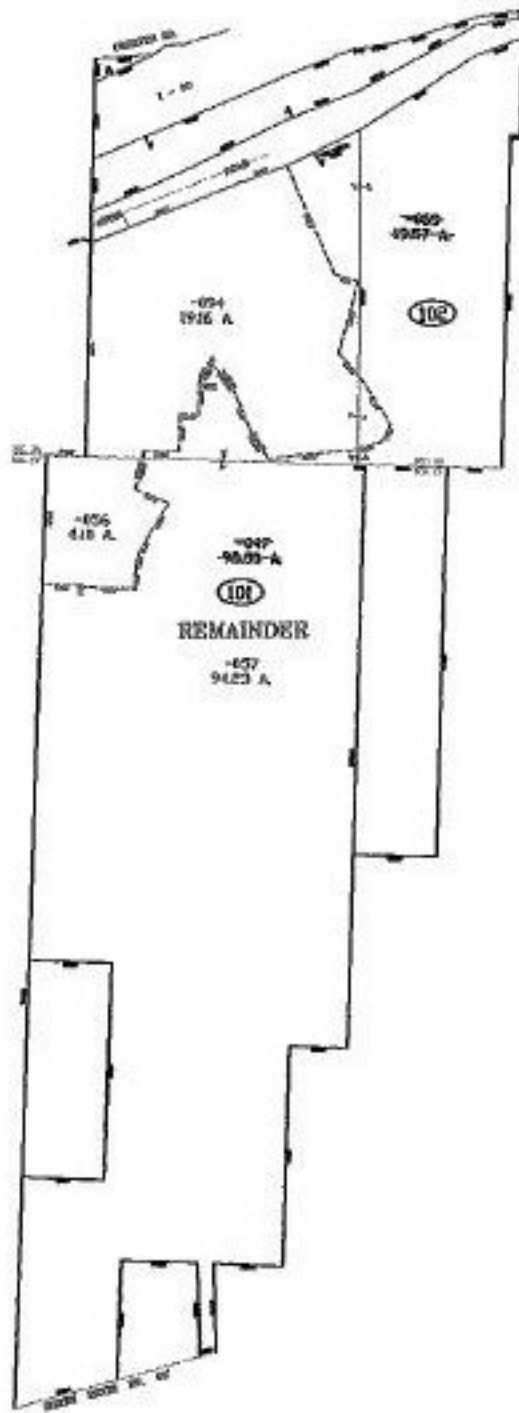

SPLITS/DEEDS PROCESSED
LORAIN COUNTY TAX MAP DEPARTMENT
226 MIDDLE AVE. ELYRIA, OHIO

SURVEYED BY: DAVID L. ELWELL
CLOSURE: 0.01 : 10,000
MAP PAGE(S): 04-00-027-B&F , -028 F&G
APPROVED BY: TJS DATE: 9/20/02
SCALE: 1" = 800' PRIOR INSTRUMENT: DV XXXX/XXX