
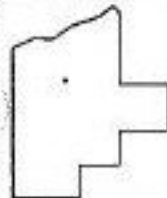


PARENT PARCEL: 04-00-023-101-007, 003 04-00-023-102-038

CHILD PARCEL: 04-00-023-101-008 THRU -011

STARTING POINT: CENTERLINE OF JAYCOX RD. & O.L. 23

NO. 01216

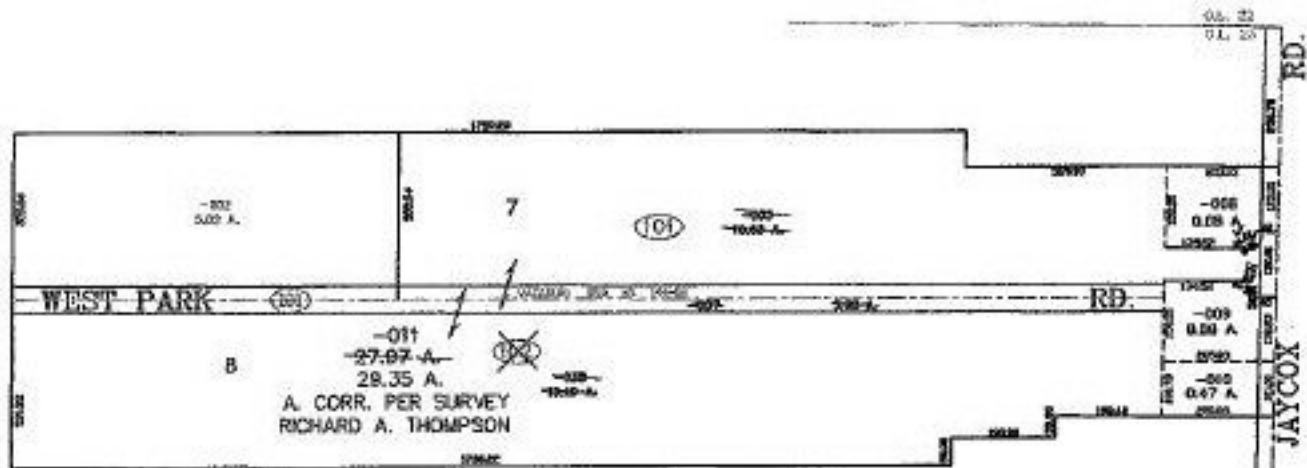

**SPLITS/DEEDS PROCESSED**  
LORAIN COUNTY TAX MAP DEPARTMENT  
226 MIDDLE AVE. ELYRIA, OHIO

SURVEYED BY: RICHARD A. THOMPSON  
CLOSURE: 0.00 : 10.000  
MAP PAGE(S): 04-00-023-B  
APPROVED BY: JAH DATE: 11-1-02  
SCALE: 1" = 400. PRIOR INSTRUMENT: OR 1451/556