
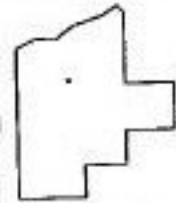


PARENT PARCEL: 03-00-001-000-120
CHILD PARCEL: 03-00-001-000-143, -144
STARTING POINT: CENTERLINE OF HOAG DR. & ABBE RD.

NO. 01218

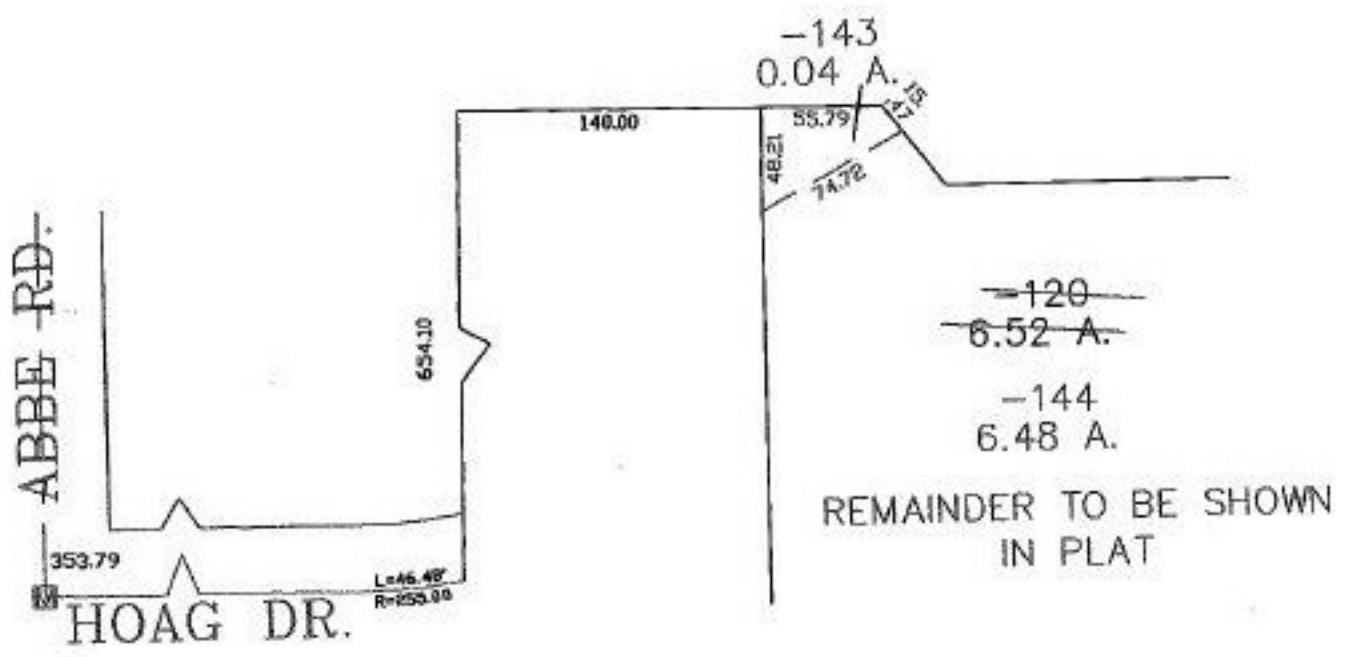

SPLITS/DEEDS PROCESSED

LORAIN COUNTY TAX MAP DEPARTMENT
226 MIDDLE AVE. ELYRIA, OHIO

SURVEYED BY: RAYMOND FOOS
CLOSURE: 0.00 : 10.000
MAP PAGE(S): 3-00-001-A
APPROVED BY: JAH DATE: 10-3-02
SCALE: 1" = 100' PRIOR INSTRUMENT: OR 1439/488