


EASTER

PARENT PARCEL: 08-00-081-000-031

CHILD PARCEL: 08-00-081-000-032, -033

STARTING POINT: CENTERLINE OF DEAN RD. & O.L. 81

NO. 01229

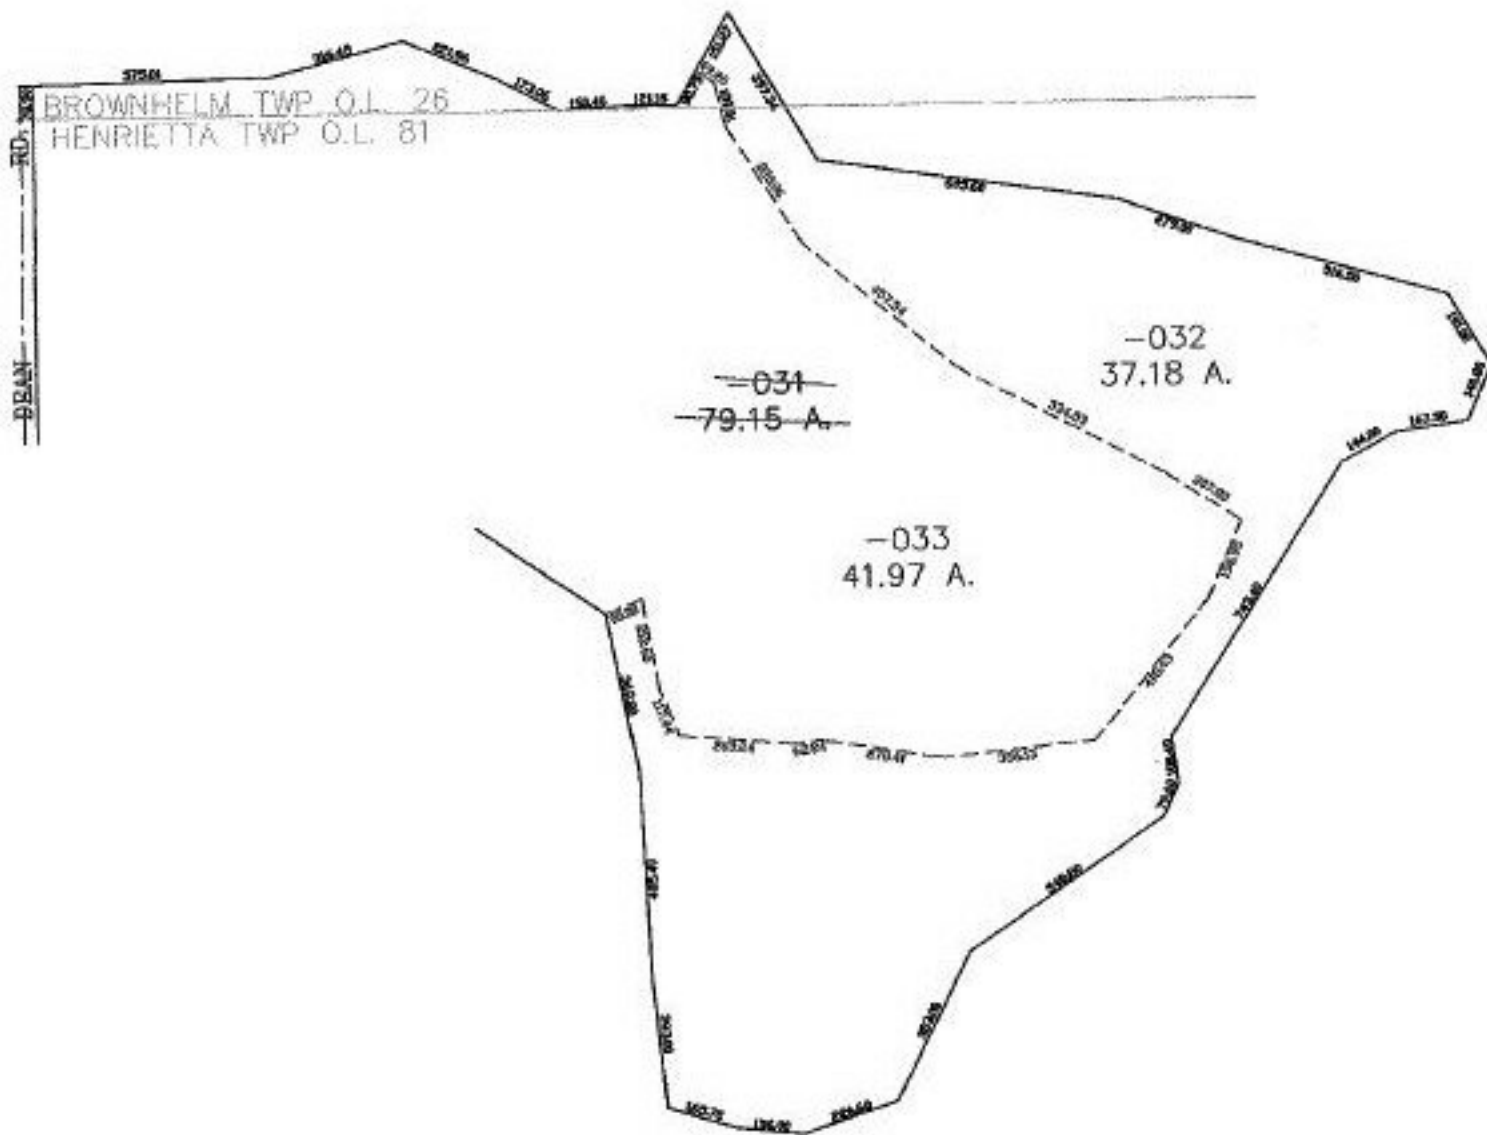

**SPLITS/DEEDS PROCESSED**

LORAIN COUNTY TAX MAP DEPARTMENT  
226 MIDDLE AVE. ELYRIA, OHIO

SURVEYED BY: THOMAS A. SIMON

CLOSURE: 0.01 : 10,000

MAP PAGE(S): 8-A, 1-1

APPROVED BY: JAH DATE: 10-24-02

SCALE: 1" = 100' PRIOR INSTRUMENT: 19980522476