

MASTER

PARENT PARCEL: 04-00-025-000-221

CHILD PARCEL: 04-00-025-000-271, -272



STARTING POINT: CENTERLINE OF LEAR NAGLE RD. & ST. FRANCIS DR.

NO. 01241



ST. FRANCIS DR. LYONS GATE RUN

LEAR NAGLE RD. 673.12  
684.23

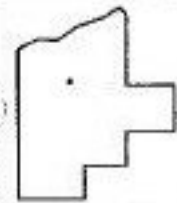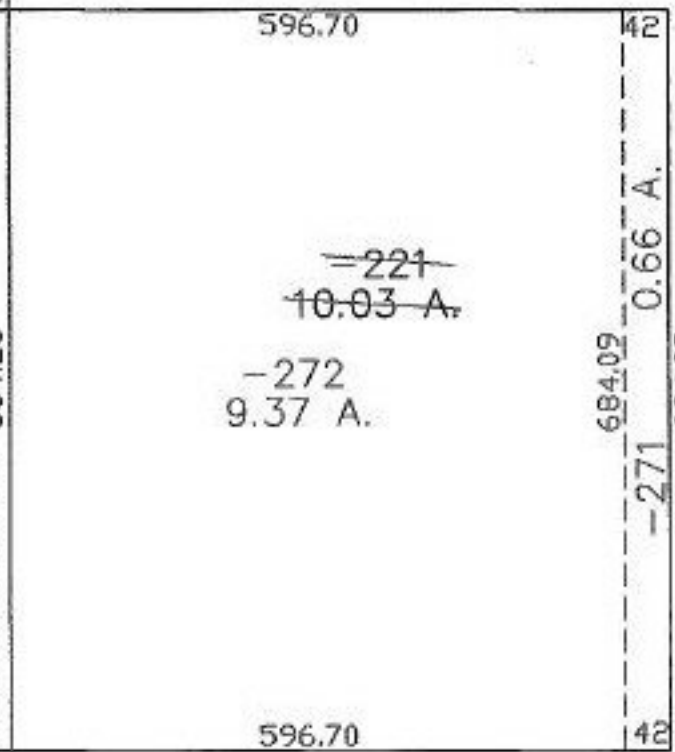

**SPLITS/DEEDS PROCESSED**  
LORAIN COUNTY TAX MAP DEPARTMENT  
226 MIDDLE AVE. ELYRIA, OHIO

SURVEYED BY: TERIN J. KAMINSKI  
CLOSURE: 0.00 : 10.000  
MAP PAGE(S): 04-00-025-E  
APPROVED BY: JAH DATE: 10-29-02  
SCALE: 1" = 200 PRIOR INSTRUMENT: DV 1410/722