
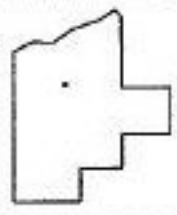


RASTER

PARENT PARCEL: 12-00-052-000-019, 12-00-053-000-012
CHILD PARCEL: 12-00-052-000-041 -042 12-00-053-000-040, -041
STARTING POINT: CENTERLINE OF COLUMBIA WEST RIVER RD. & O.L. 53

NO. 01242

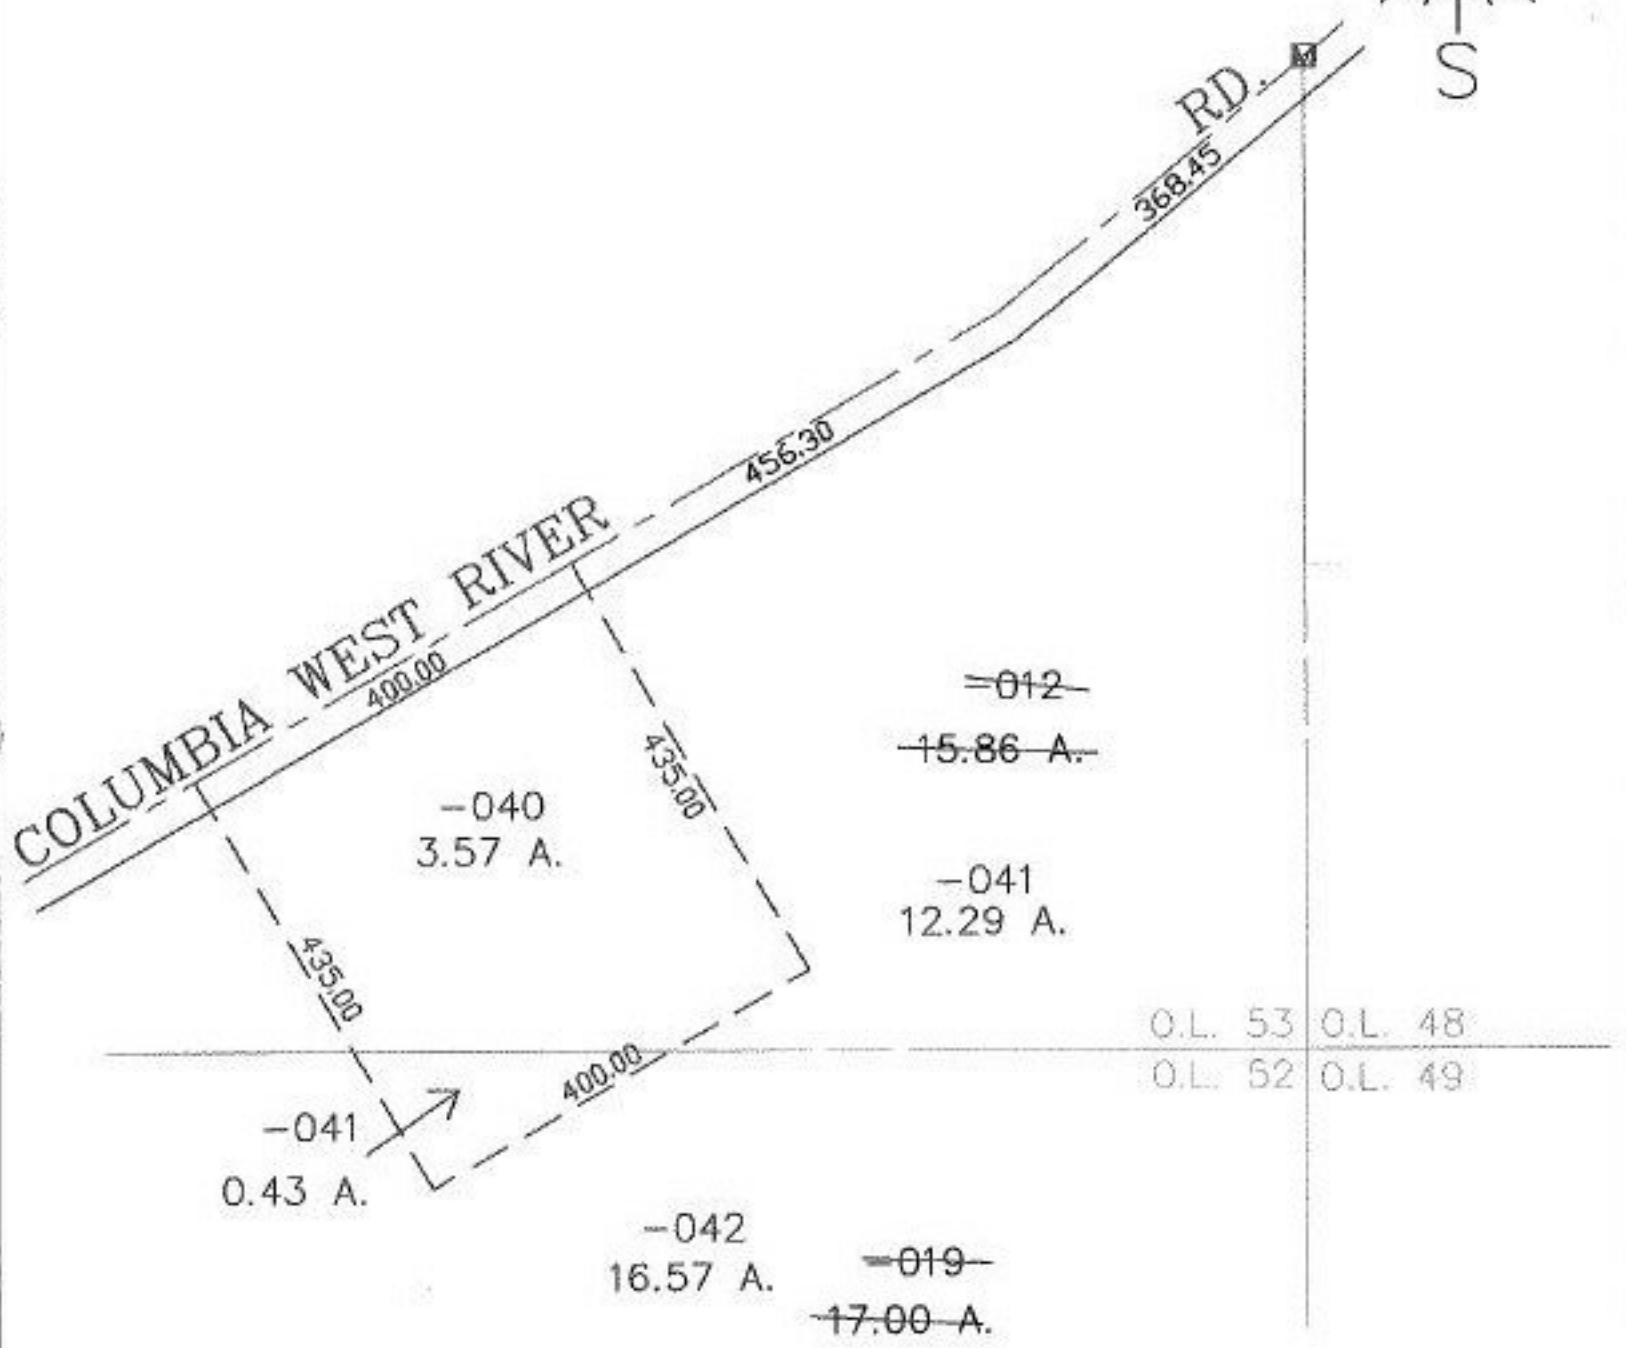

SPLITS/DEEDS PROCESSED
LORAIN COUNTY TAX MAP DEPARTMENT
226 MIDDLE AVE. ELYRIA, OHIO

SURVEYED BY: RICHARD F. HANTEL
CLOSURE: 0.00 : 10.000
MAP PAGE(S): 12-F
APPROVED BY: JAH DATE: 11-6-02
SCALE: 1" = 200' PRIOR INSTRUMENT: 990658042