


MASTER

PARENT PARCEL: 07-00-016-104-172


CHILD PARCEL: 07-00-016-104-174 THRU -176

STARTING POINT: WEST RIGHT OF WAY OF PITTS BLVD. & S/L 1 OF WIL-LOU ACRES SUBD.

NO. 01252

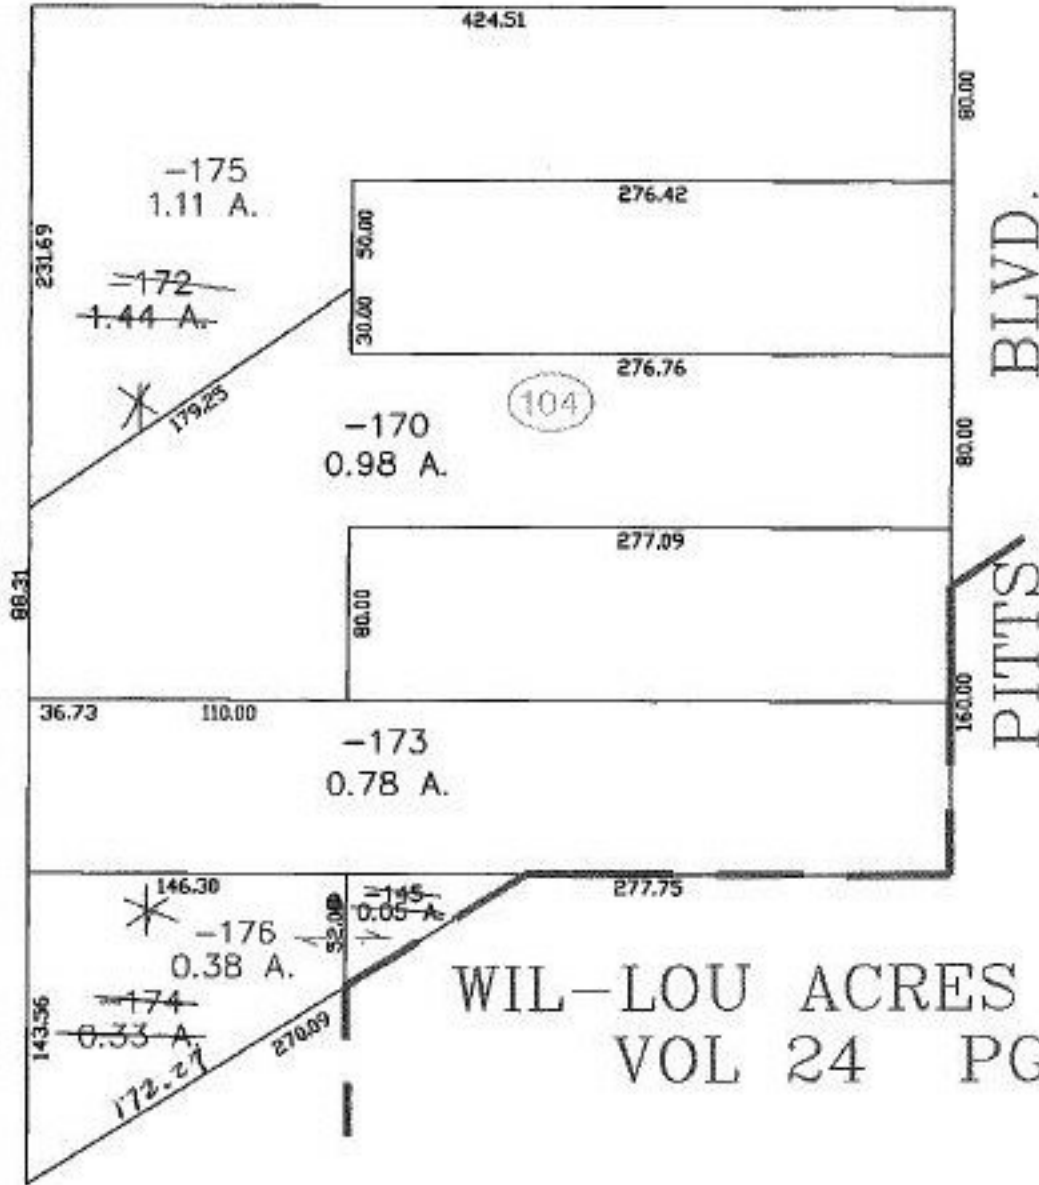

WIL-LOU ACRES SUB NO 1
VOL 24 PG 96

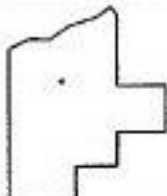

SPLITS/DEEDS PROCESSED

LORAIN COUNTY TAX MAP DEPARTMENT
226 MIDDLE AVE. ELYRIA, OHIO

SURVEYED BY: DANE A. HAPONEK

CLOSURE: 0.00 : 10.000

MAP PAGE(S): 07-00-016-B

APPROVED BY: JAH DATE: 11-14-02

SCALE: 1" = 100 PRIOR INSTRUMENT: 980529570