


FASTER

PARENT PARCEL: 11-00-078-000-033

CHILD PARCEL: 11-00-078-000-034 THRU -038

STARTING POINT: CENTERLINE OF DURKEE RD. & CAPEL RD.

NO. 01256

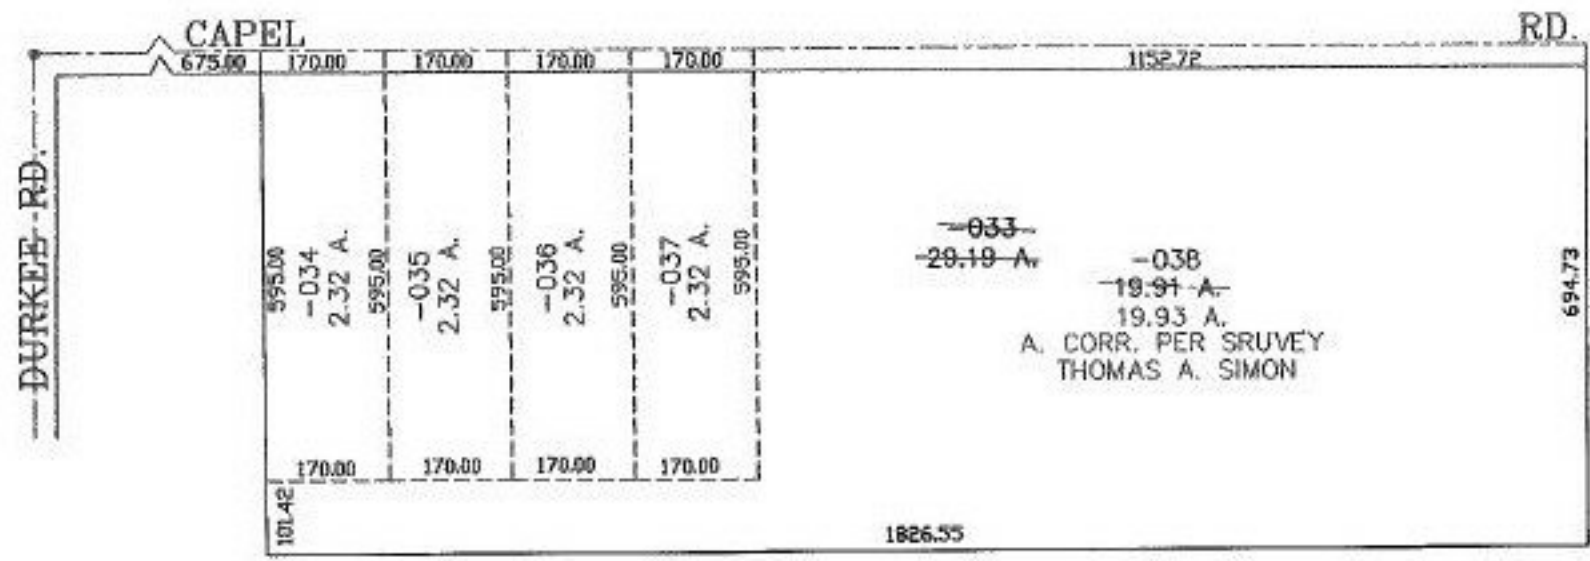

SPLITS/DEEDS PROCESSED
 LORAIN COUNTY TAX MAP DEPARTMENT
 226 MIDDLE AVE. ELYRIA, OHIO

SURVEYED BY: THOMAS A. SIMON
 CLOSURE: 0.00 : 10,000
 MAP PAGE(S): 11-00-078-B
 APPROVED BY: JAH DATE: 11-18-02
 SCALE: 1" = 300' PRIOR INSTRUMENT: OR 178/773