


PARENT PARCEL: 04-00-018-128-205, -028, -184
CHILD PARCEL: 04-00-018-128-226 THRU -228
STARTING POINT: CENTERLINE OF WALKER RD. & AVON-BELDEN RD.

NO. 01257

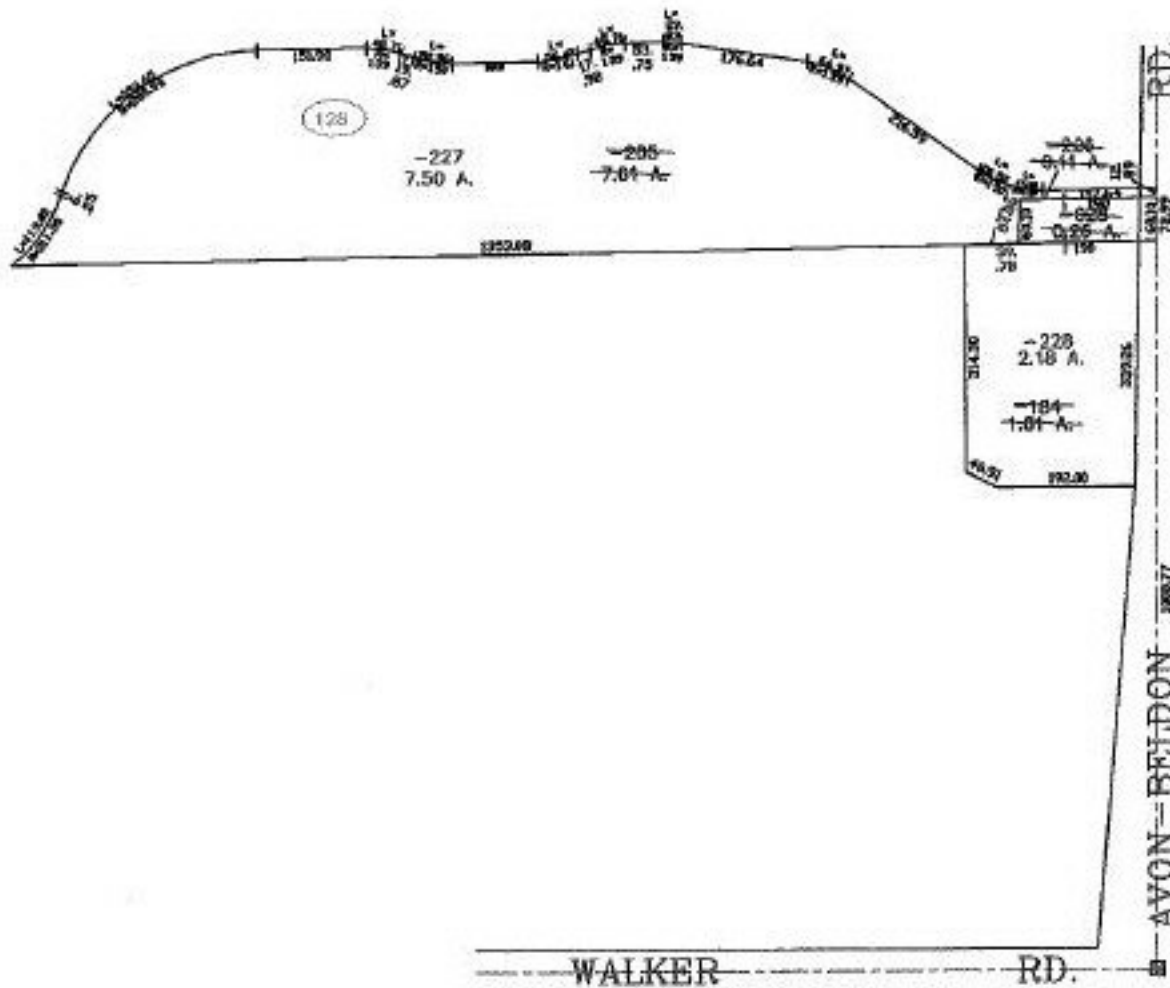

SPLITS/DEEDS PROCESSED
LORAIN COUNTY TAX MAP DEPARTMENT
226 MIDDLE AVE. ELYRIA, OHIO

SURVEYED BY: DAVID L. ELWELL
CLOSURE: 0.00 : 10.000
MAP PAGE(S): 4-00-018-J
APPROVED BY: JAH DATE: 11-19-02
SCALE: 1" = 300 PRIOR INSTRUMENT: 990619412