


PARENT PARCEL: 02-01-003-270-012

CHILD PARCEL: 02-01-003-270-031, -032

STARTING POINT: CENTERLINE OF COOPER FOSTER PARK RD. & CHERRYWOOD DR.

NO. 01262

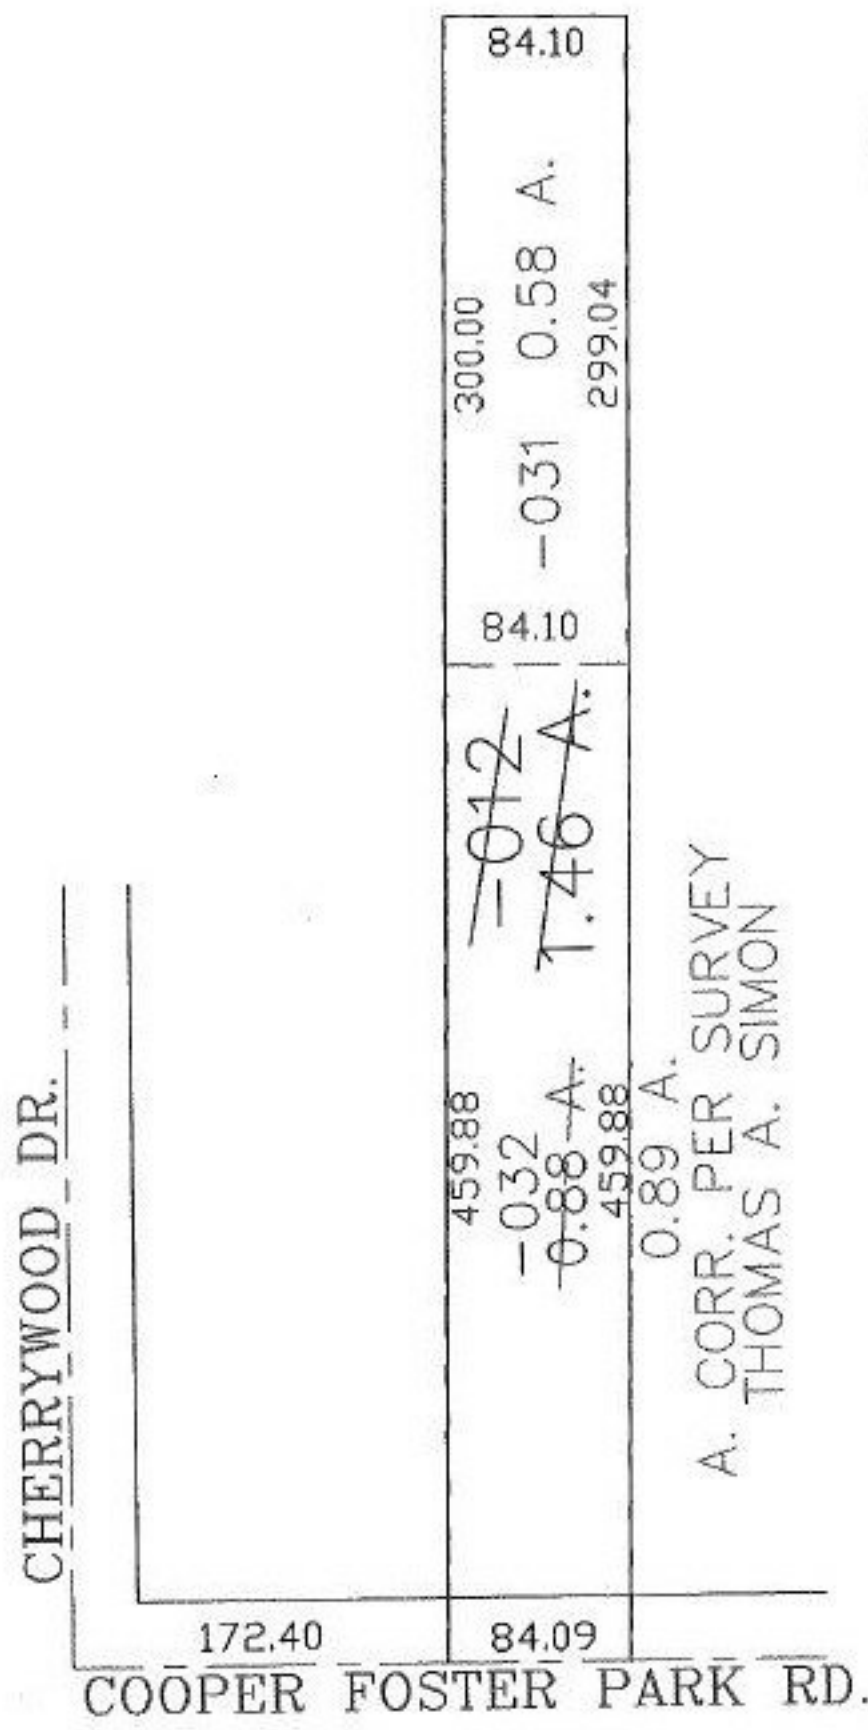

SPLITS/DEEDS PROCESSED

LORAIN COUNTY TAX MAP DEPARTMENT  
228 MIDDLE AVE. ELYRIA, OHIO

SURVEYED BY: THOMAS A. SIMON

CLOSURE: 0.00 : 10.000

MAP PAGE(S): 02-01-003-N

APPROVED BY: JAH DATE: 12-2-02

SCALE: 1" = 100 PRIOR INSTRUMENT: