

No 01267
 APPROVED
 LOR. CO.
 MAPS & SURV.
 DATE 12-5-02
 BY R. HARRIS
 02-01267

O.L. 48
 RIDGEVILLE TWP.

RASTER

ELYRIA TWP.
 O.L. 1
 O.L. 5
 CARLISE TWP.

STATE ROUTE 57

O.L. 91
 EATON TWP.


WESTIN WAY

CHESTNUT RIDGE RD.

AC. CORR. PER SURV.
 BY M. YEAGER

SEE DETAIL

DETAIL

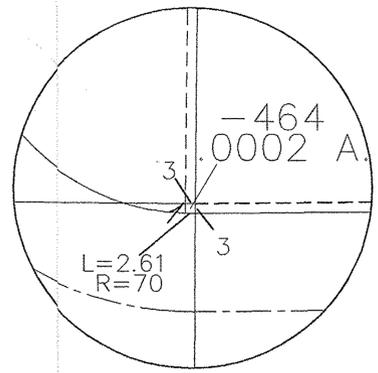

~~-023~~ ~~-125~~
~~0.21 A.~~ ~~0.07 A.~~

~~-179~~
~~5.09 A.~~

~~-200~~
~~4.54 A.~~
~~4.56 A.~~

~~-385~~
~~1.27 A.~~

~~-465~~
~~1.27 A.~~

1071.06
 1071.51

3.00

2874.01

798.94

133.09
 150.00
 150.00
 -199
 0.55 A.
 147.00

567.65

420.62