


EASTER

PARENT PARCEL: 16-00-071-000-005

CHILD PARCEL: 16-00-071-000-008, -009

STARTING POINT: CENTERLINE OF LAW RD. & O.L. 71

NO. 01270

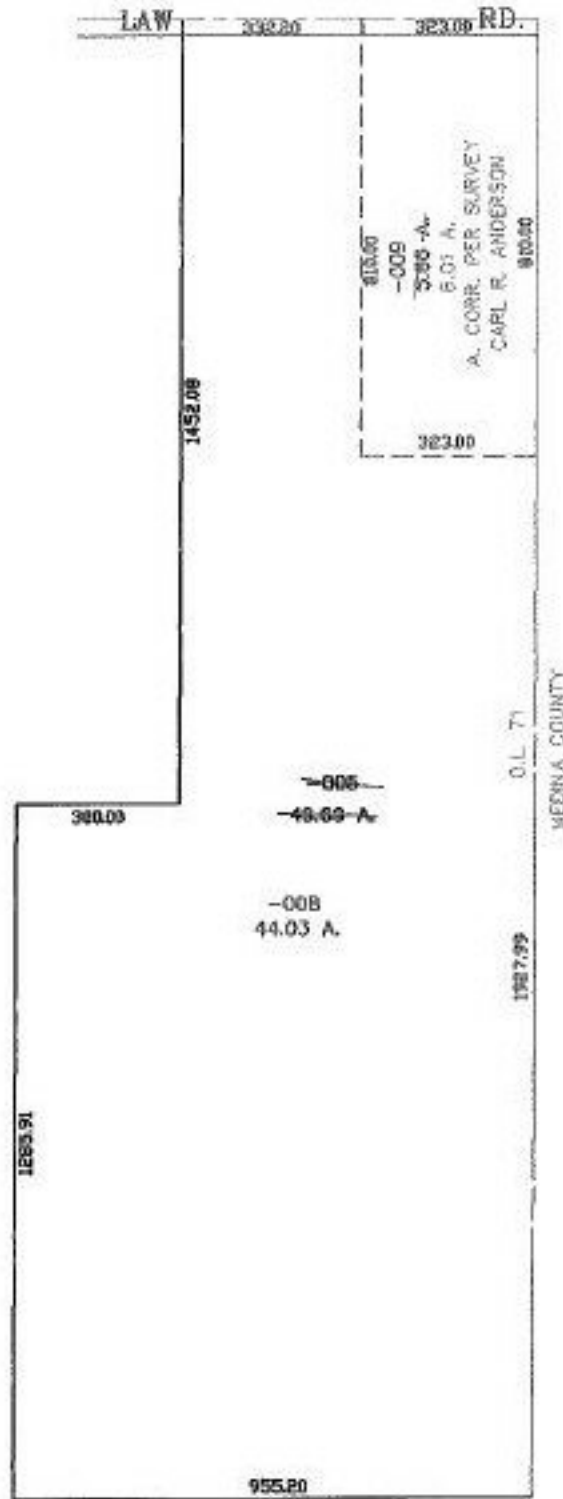

**SPLITS/DEEDS PROCESSED**

LORAIN COUNTY TAX MAP DEPARTMENT  
226 MIDDLE AVE. ELYRIA, OHIO

SURVEYED BY: CARL R. ANDERSON  
 CLOSURE: 0.00 : 10.000  
 MAP PAGE(S): 16-H  
 APPROVED BY: JAH DATE: 12-6-02  
 SCALE: 1" = 400 PRIOR INSTRUMENT: OR 1258/786