


MASTER

PARENT PARCEL: 05-00-053-000-025, -026

CHILD PARCEL: 05-00-053-000-080 THRU -084

STARTING POINT: CENTERLINE OF OBERLIN RD. & O.L. 52

NO. 01272

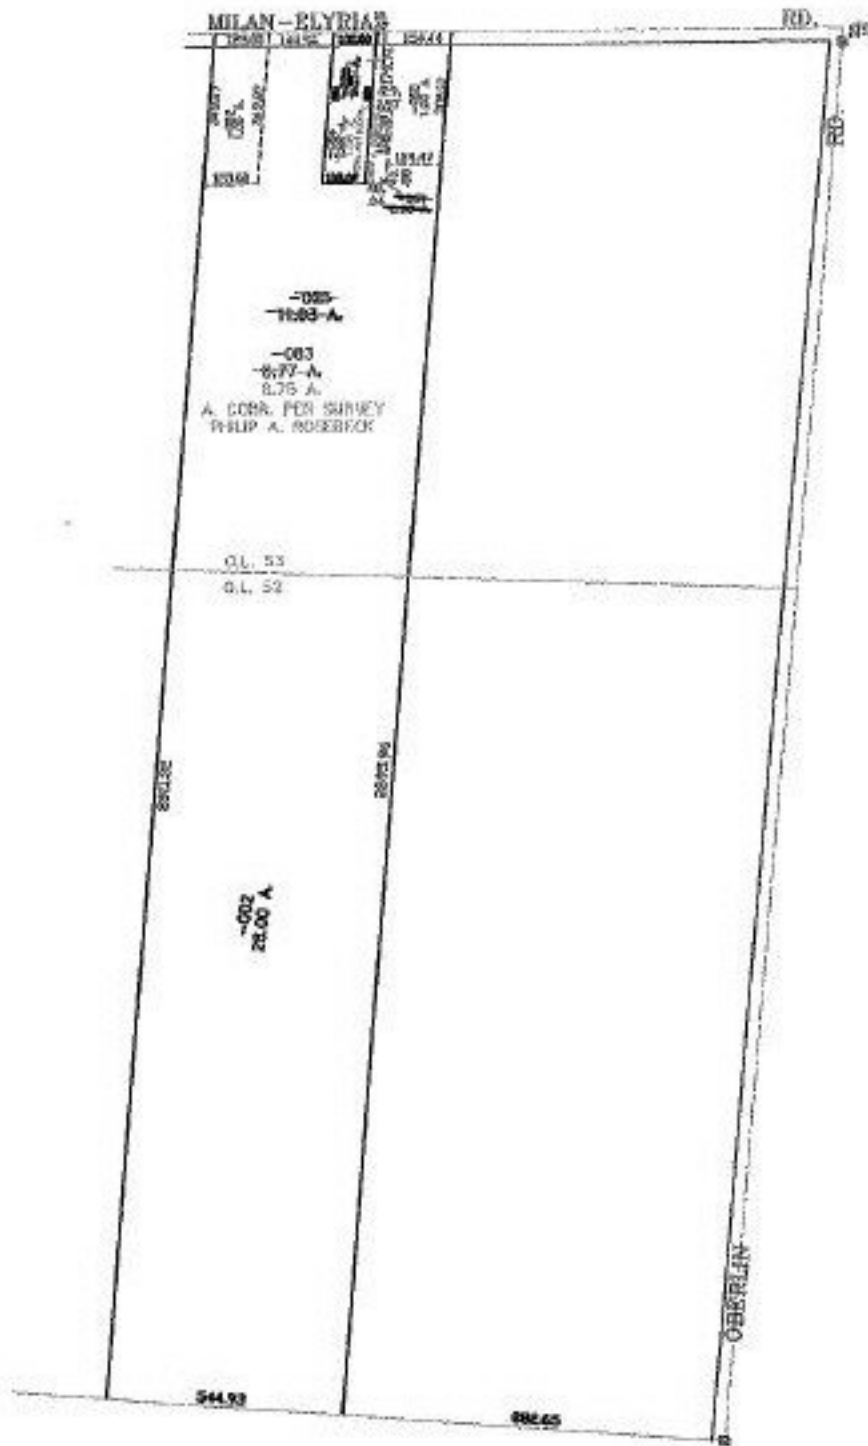

SPLITS/DEEDS PROCESSED

LORAIN COUNTY TAX MAP DEPARTMENT
226 MIDDLE AVE. ELYRIA, OHIO

SURVEYED BY: PHILIP A. ROSEBECK

CLOSURE: 0.00 : 10.000

MAP PAGE(S): 05-00-053-A

APPROVED BY: JAH DATE: 12-9-02

SCALE: 1" = 500' PRIOR INSTRUMENT: 20000707135