


PARENT PARCEL: 05-00-087-000-060, -049, -064

CHILD PARCEL: 05-00-087-000-067 THRU -072

STARTING POINT: CENTERLINE OF ELYRIA MILAN RD. & OLD WEST RIDGE RD.

NO. 01279

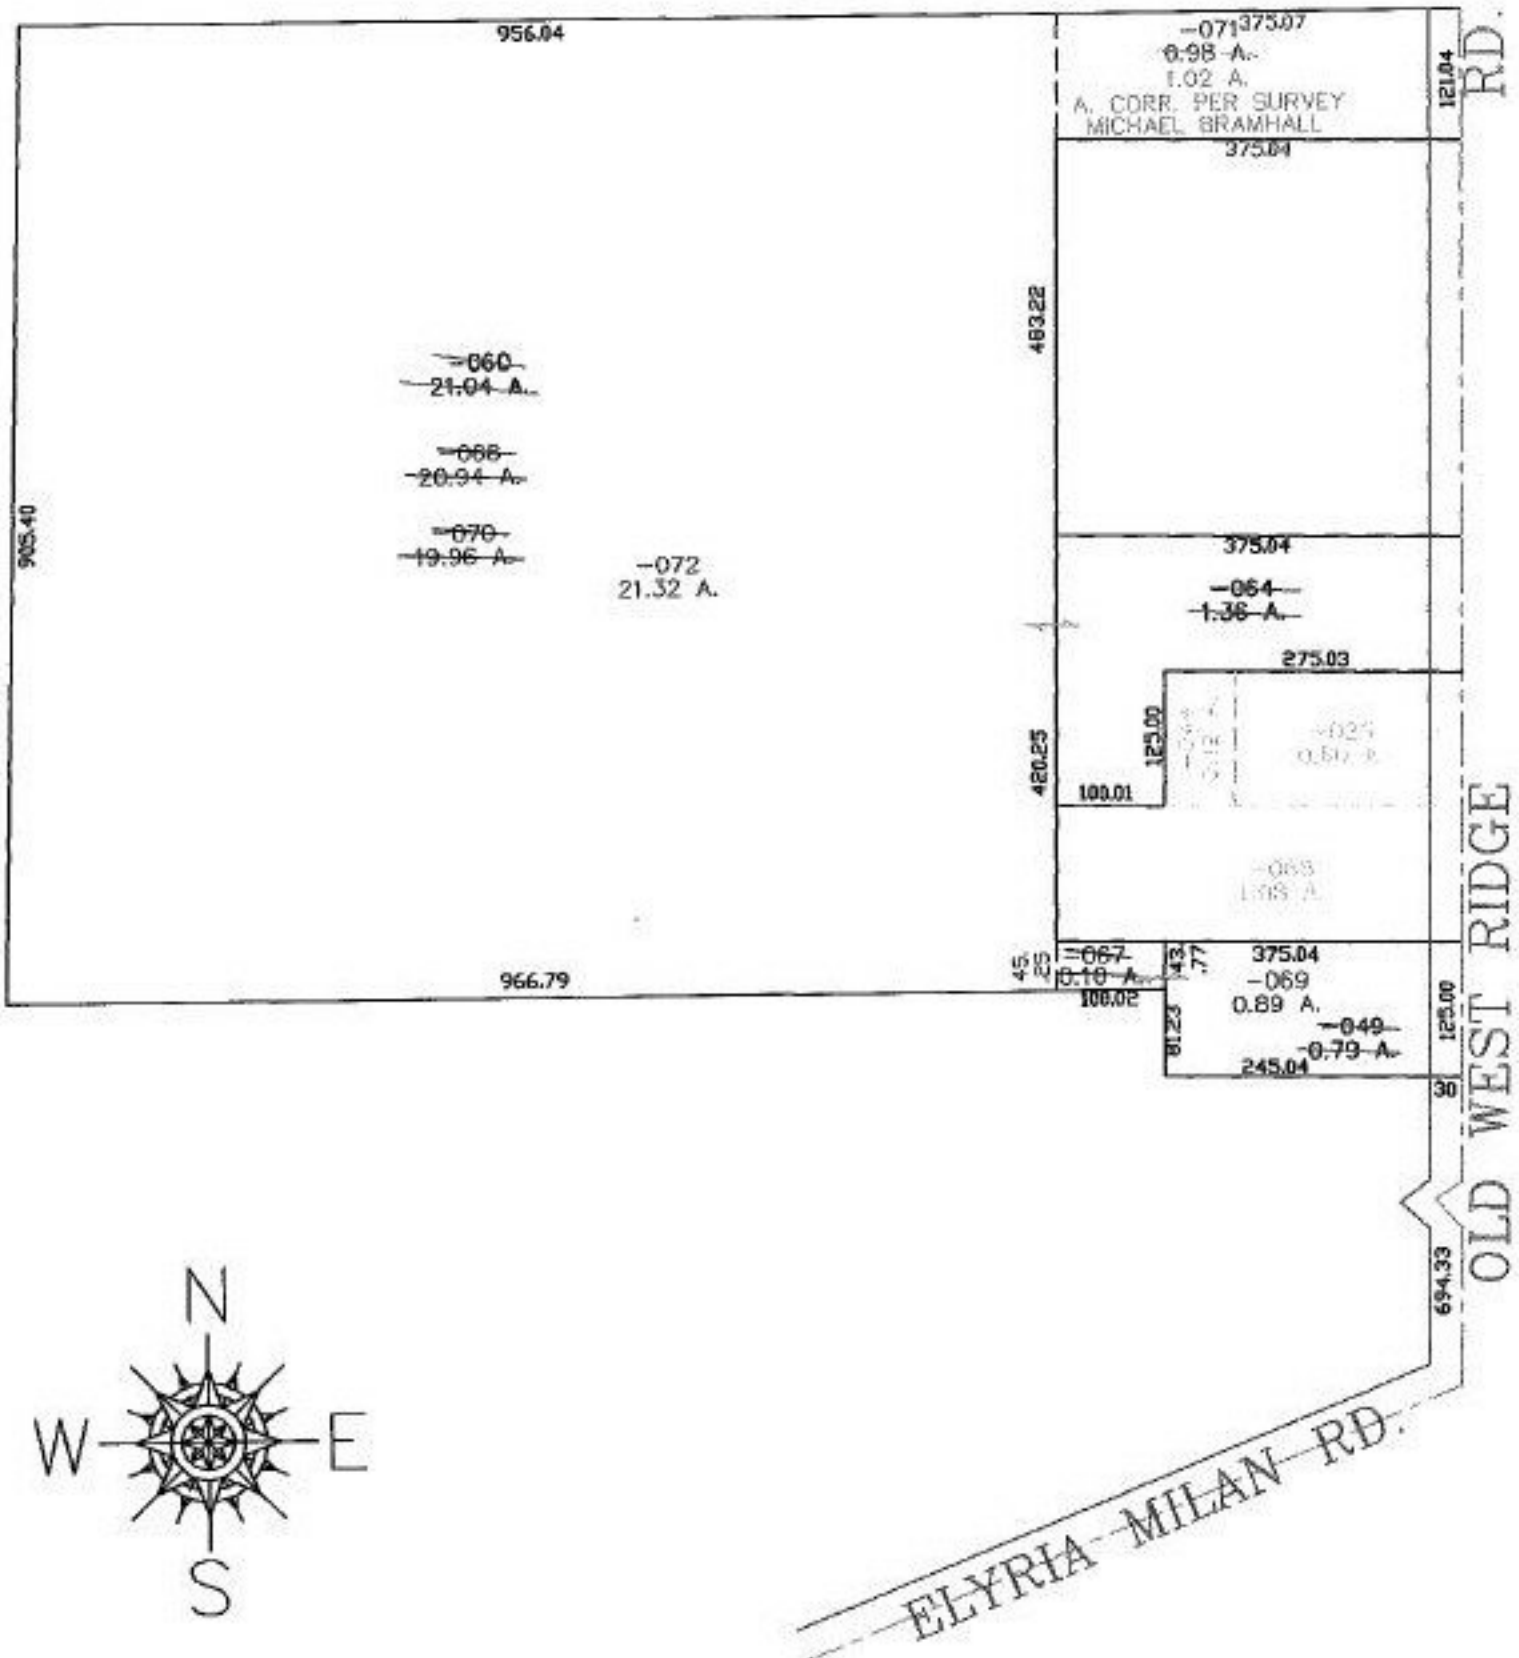

**SPLITS/DEEDS PROCESSED**  
 LORAIN COUNTY TAX MAP DEPARTMENT  
 226 MIDDLE AVE. ELYRIA, OHIO

SURVEYED BY: MICHAEL BRAMHALL  
 CLOSURE: 0.00 : 10.000  
 MAP PAGE(S): 05-00-087  
 APPROVED BY: JAH DATE: 12-30-02  
 SCALE: 1" = 200' PRIOR INSTRUMENT: OR 1193/266