
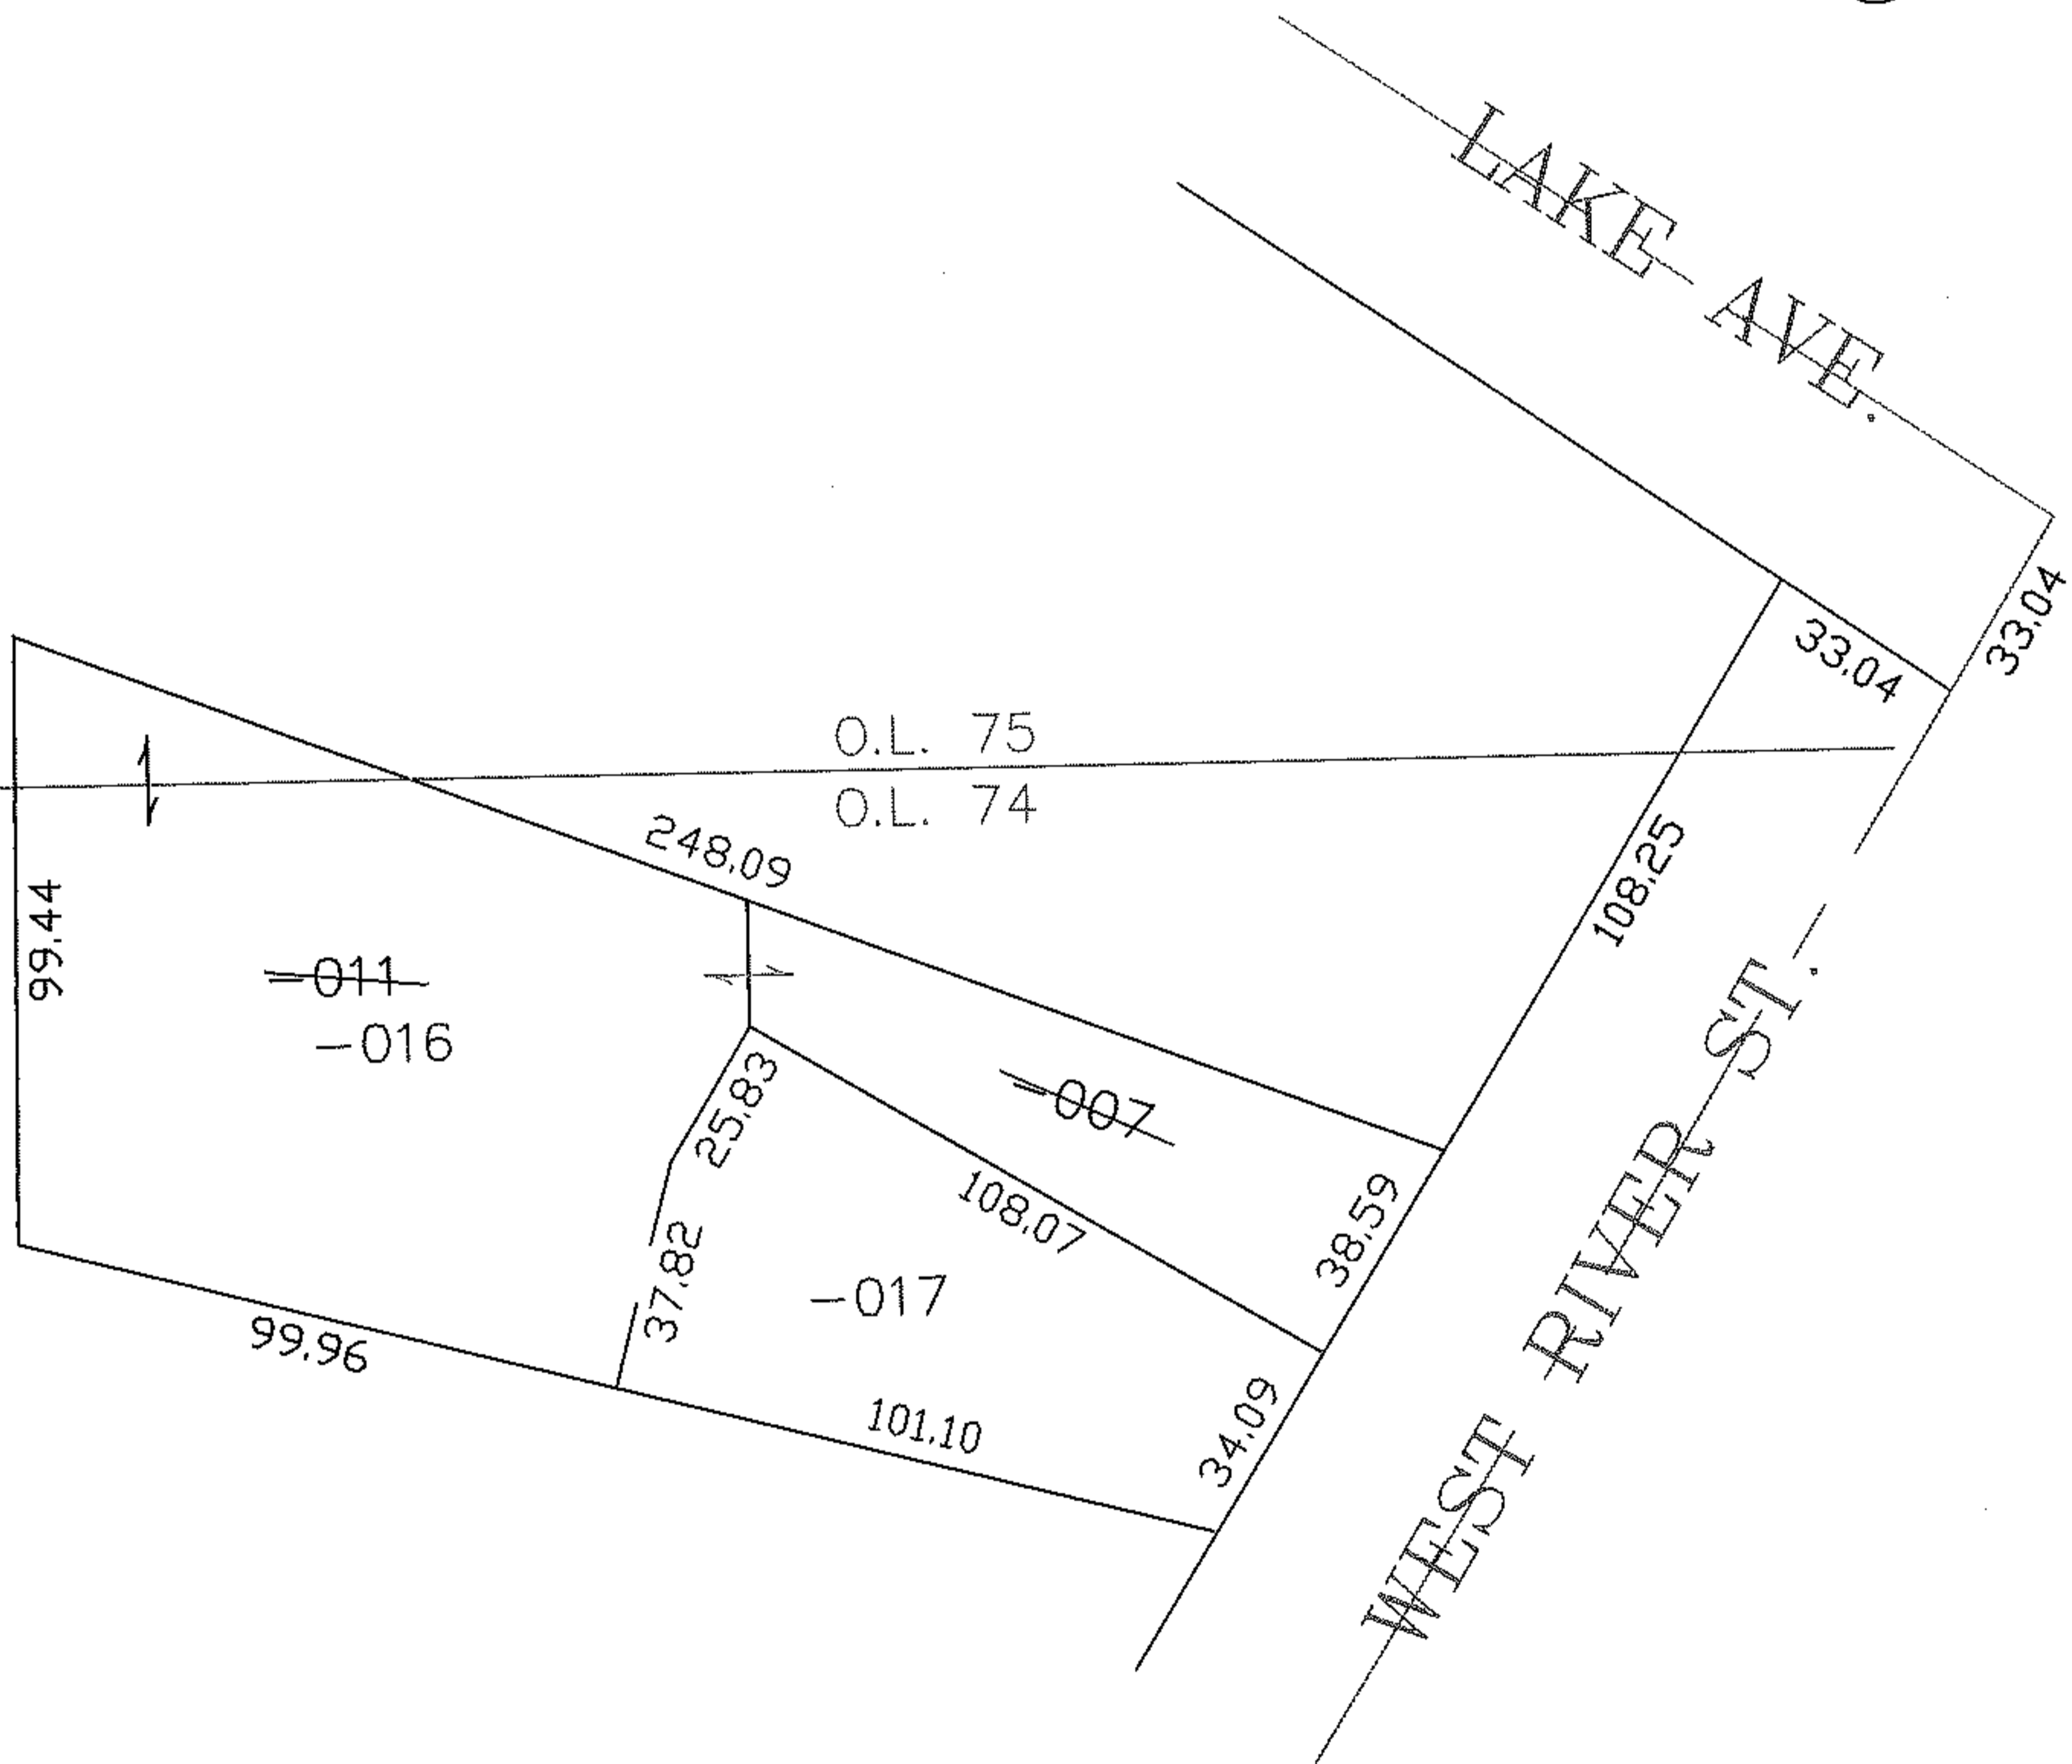


PARENT PARCEL: 06-24-074-000-011, -007

CHILD PARCEL: 06-24-074-000-016, -017

STARTING POINT: CENTERLINE OF LAKE AVE & WEST RIVER ST.

05-02001

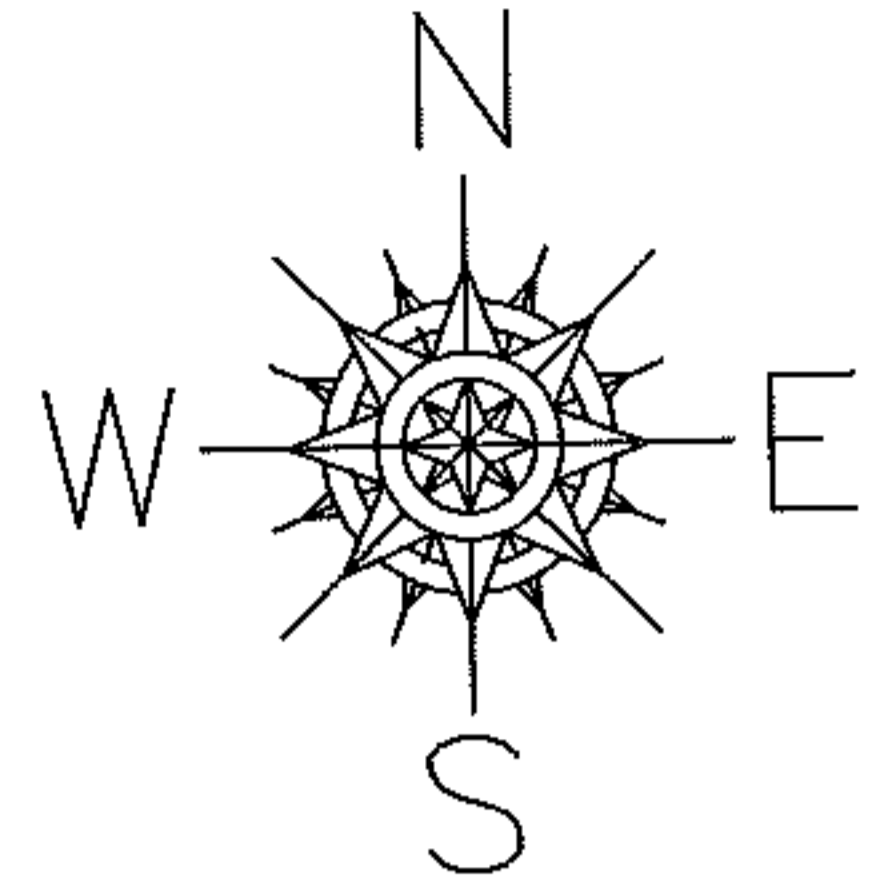

SPLITS/DEEDS PROCESSED

LORAIN COUNTY TAX MAP DEPARTMENT  
226 MIDDLE AVE. ELYRIA, OHIO

SURVEYED BY: CHRISTOPHER HIRZEL

CLOSURE: 0.00 : 10.000

MAP PAGE(S): 6-100

APPROVED BY: JAH DATE: 9-13-05

SCALE: 1" = 100 PRIOR INSTRUMENT: DV 1006/734