


PARENT PARCEL: 11-00-032-000-011

CHILD PARCEL: 11-00-032-000-019 & -020

STARTING POINT: CL OF ISLAND RD. & CL OF DYE RD.

10-02003-U

UNCOMBINATION


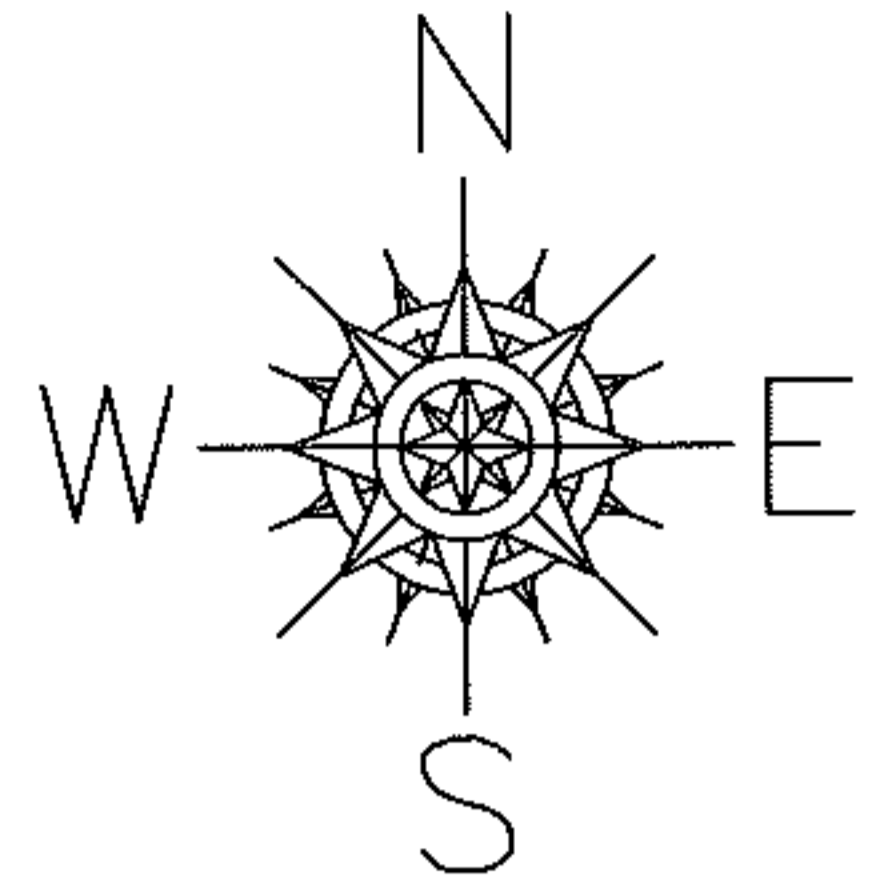


~~11-00-032-000-011~~
~~1.26 A.~~

11-00-032-000-019
0.63 A.

11-00-032-000-020
0.63 A.

PER DEED OR VOL. 313 PG. 909

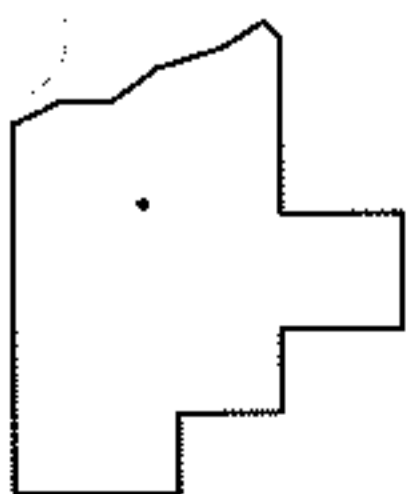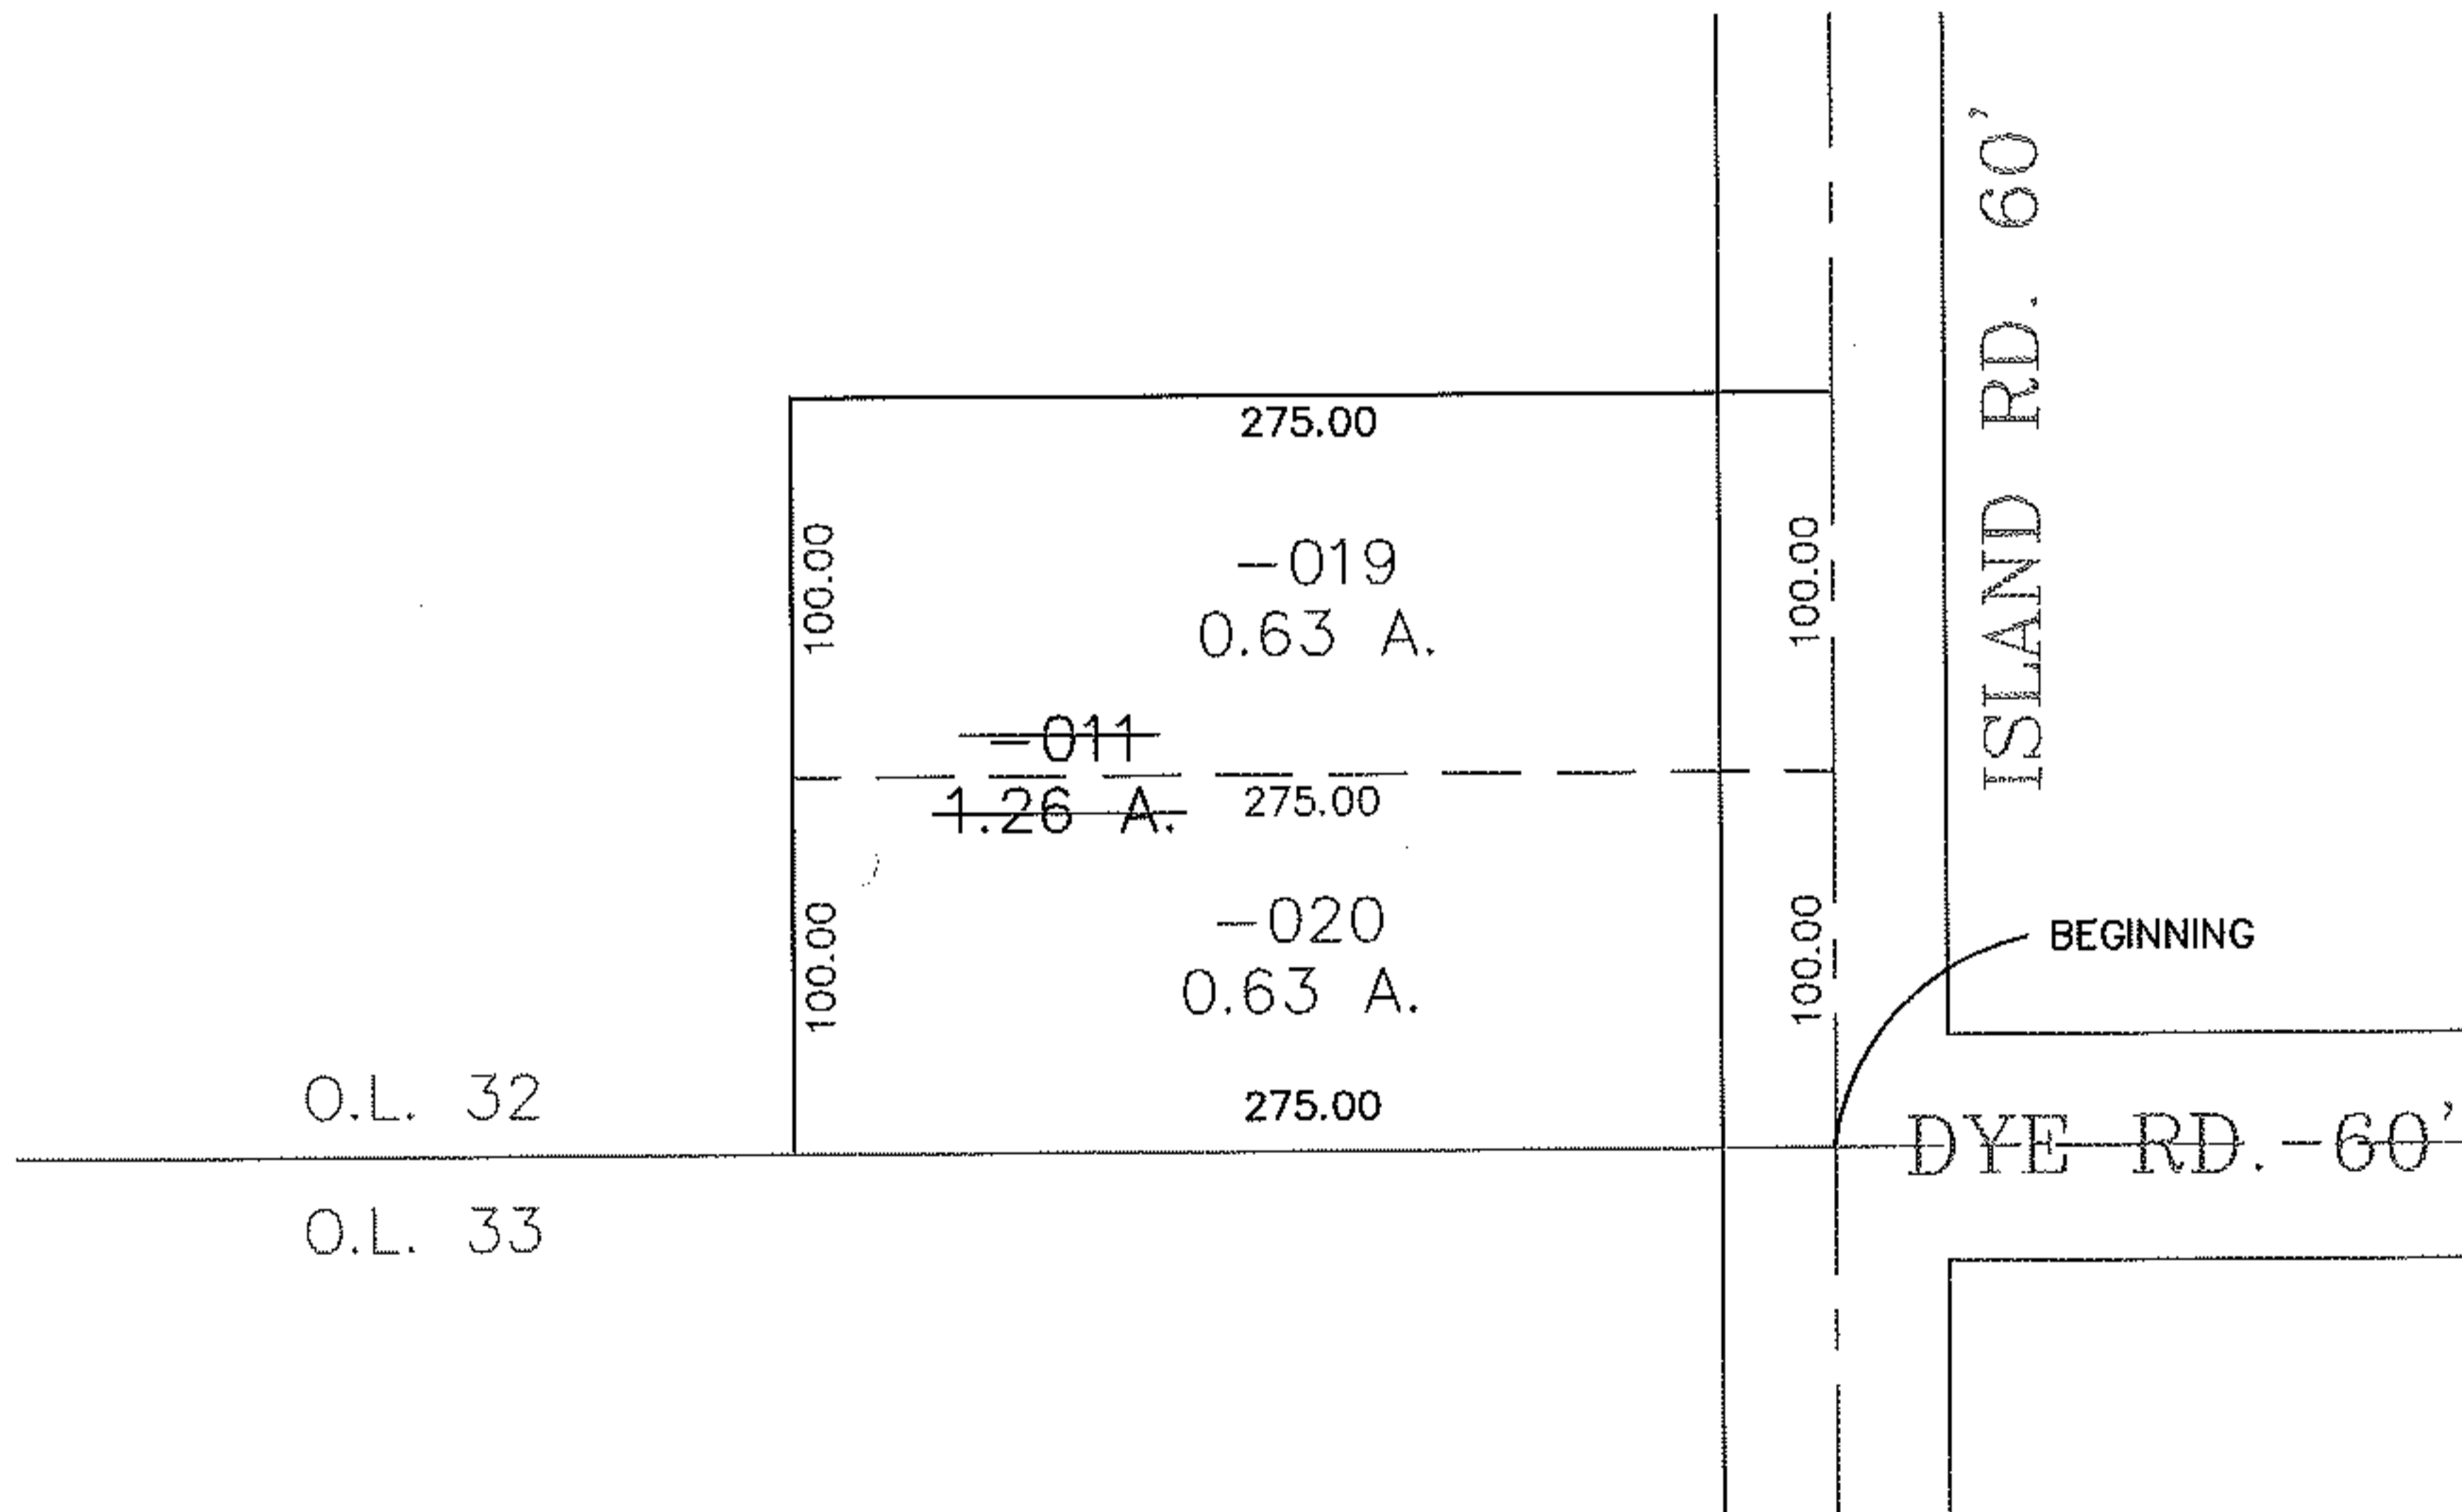

SPLITS/DEEDS PROCESSED
LORAIN COUNTY TAX MAP DEPARTMENT
226 MIDDLE AVE. ELYRIA, OHIO

SURVEYED BY: C.T. BIGGS
CLOSURE: 0.00 : 10,000
MAP PAGE(S): 11-C
APPROVED BY: TJS DATE: 4/6/10
SCALE: 1" = 100' PRIOR INSTRUMENT: OR 313/909

RASPER