




PASTER

PARENT PARCEL: 09-00-021-000-043

CHILD PARCEL: 09-00-021-000-045, -046

STARTING POINT: CENTERLINE OF RUSSIA RD. & QUARRY RD.

05-02005

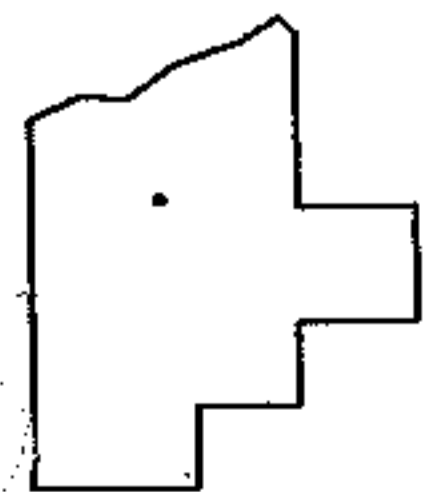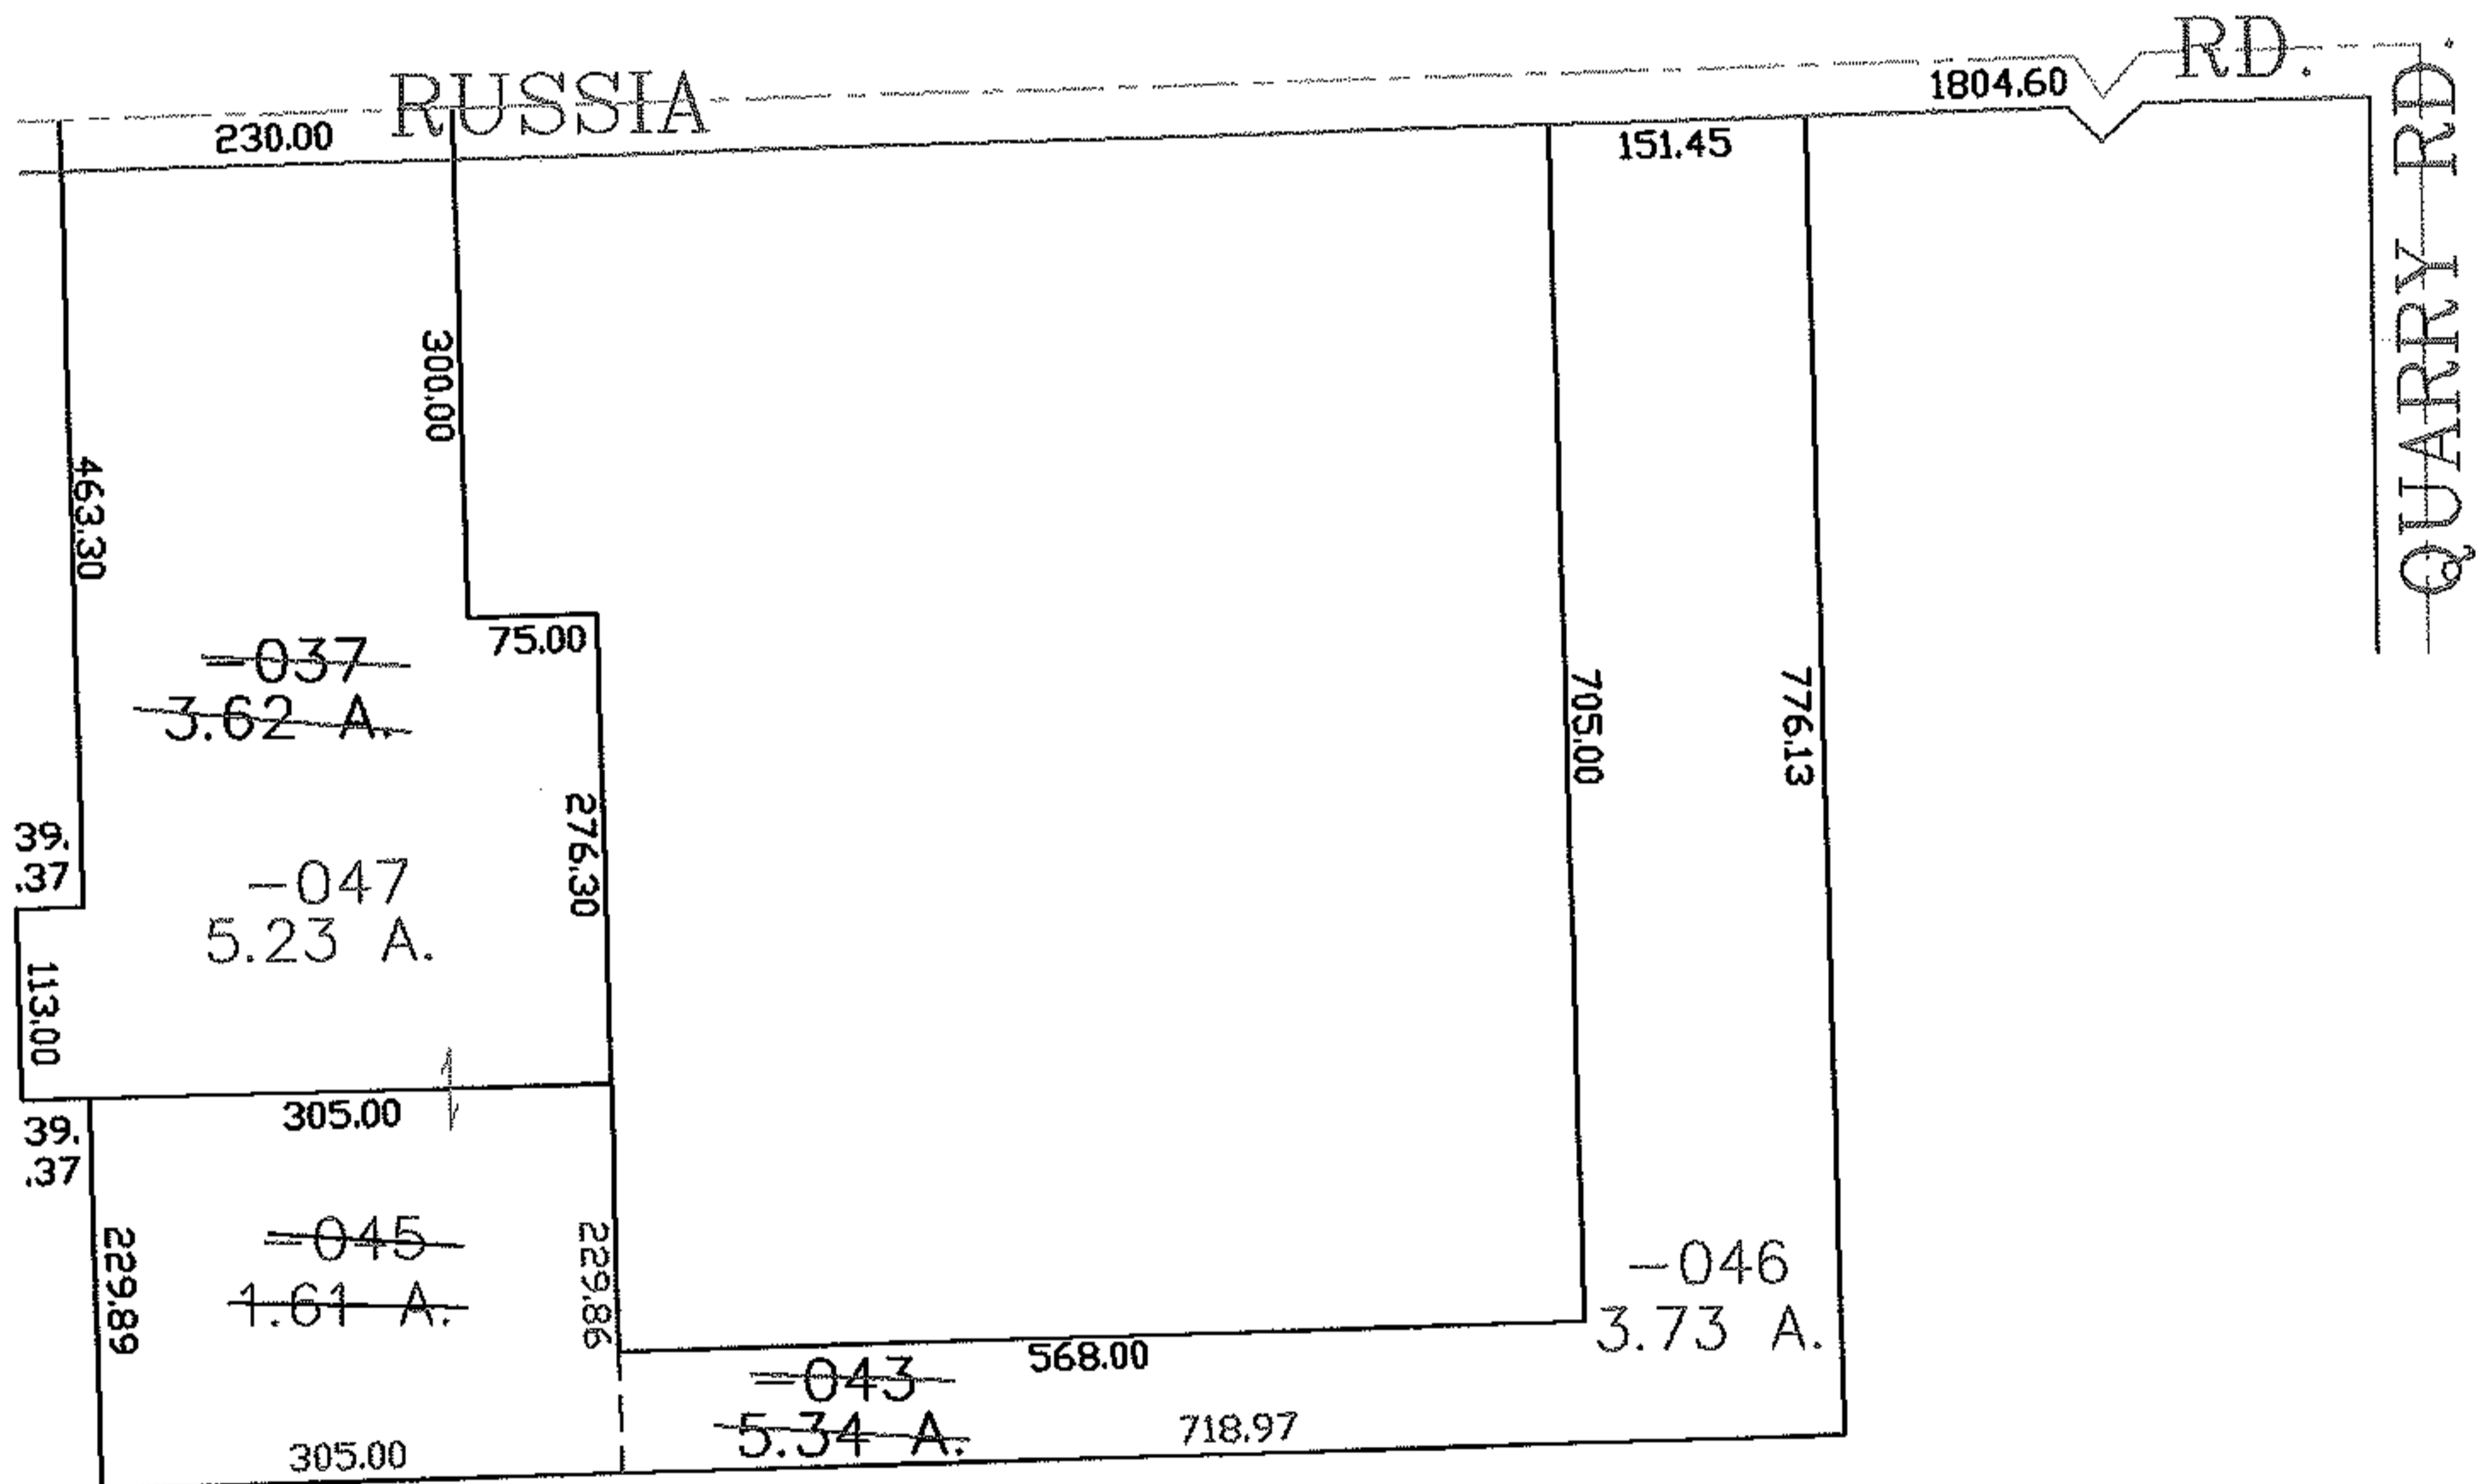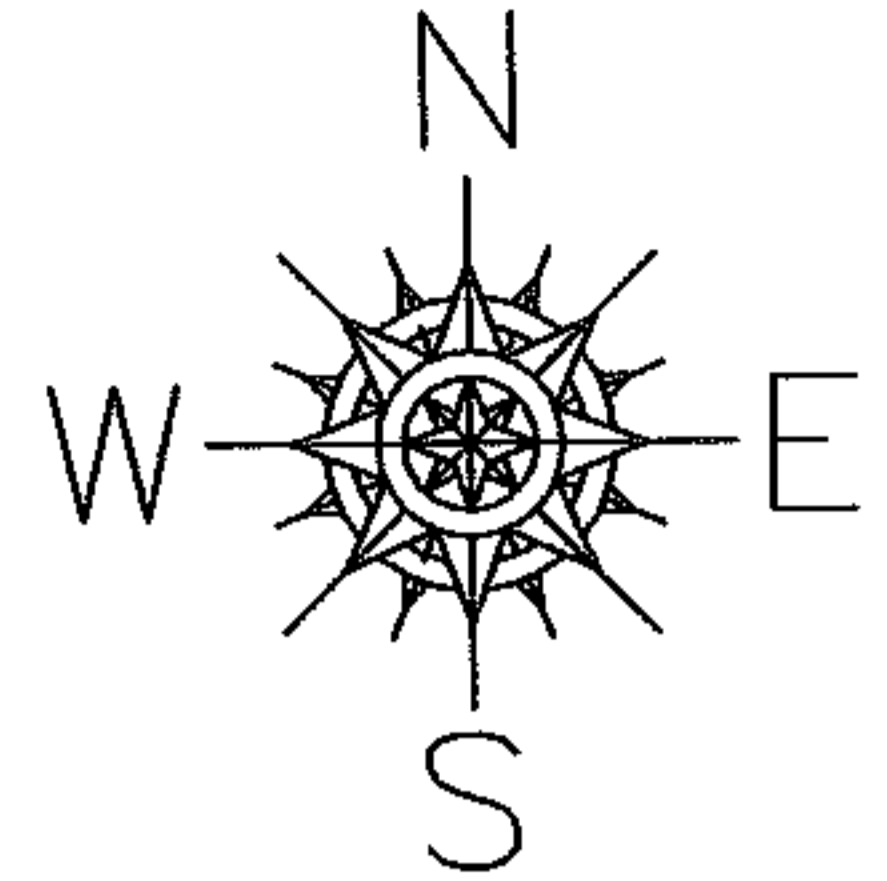

SPLITS/DEEDS PROCESSED
 LORAIN COUNTY TAX MAP DEPARTMENT
 226 MIDDLE AVE. ELYRIA, OHIO

SURVEYED BY: PAT MCGANNON
 CLOSURE: 0.00 : 10.000
 MAP PAGE(S): 09-00-021-B
 APPROVED BY: JAH DATE: 9-16-05
 SCALE: 1" = 200' PRIOR INSTRUMENT: 990621535