


PARENT PARCEL: 06-24-102-000-008

CHILD PARCEL: \_\_\_\_\_

10-02006-C

STARTING POINT: INTERSECTION OF NORTH LINE OF WOODFORD AVE. AND WEST LINE  
BALTIMORE AND OHIO R.R.

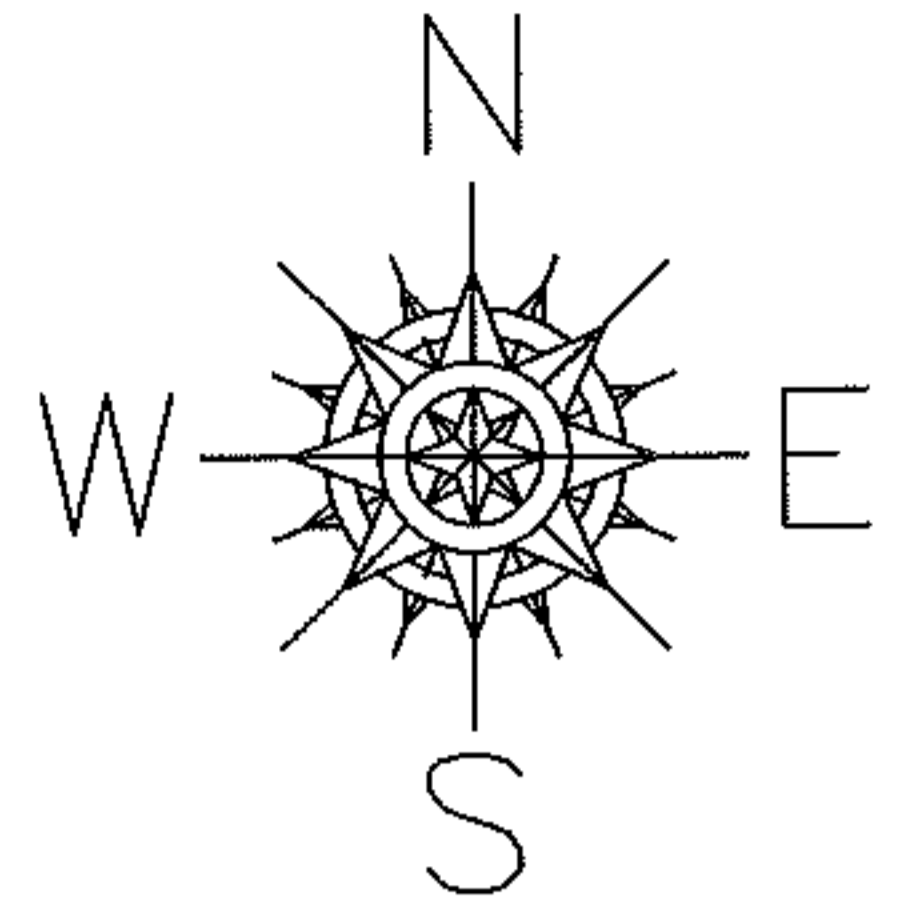


ACREAGE CORRECTION

06-24-102-000-008

0.43 A.

~~80 X~~

PER PRIOR DEEDS AND COURT CASE  
NO.10CV166058

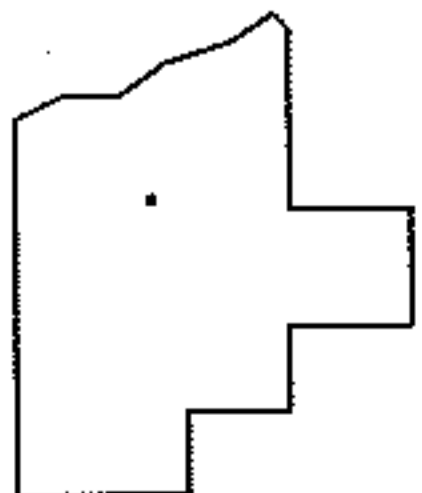

SPLITS/DEEDS PROCESSED

LORAIN COUNTY TAX MAP DEPARTMENT  
226 MIDDLE AVE. ELYRIA, OHIO

SURVEYED BY: N/A

CLOSURE: N/A

MAP PAGE(S): 6-117

APPROVED BY: RRM DATE: 4/8/10

SCALE: 1"= 100 PRIOR INST.: 20060174498

*RASTER*