
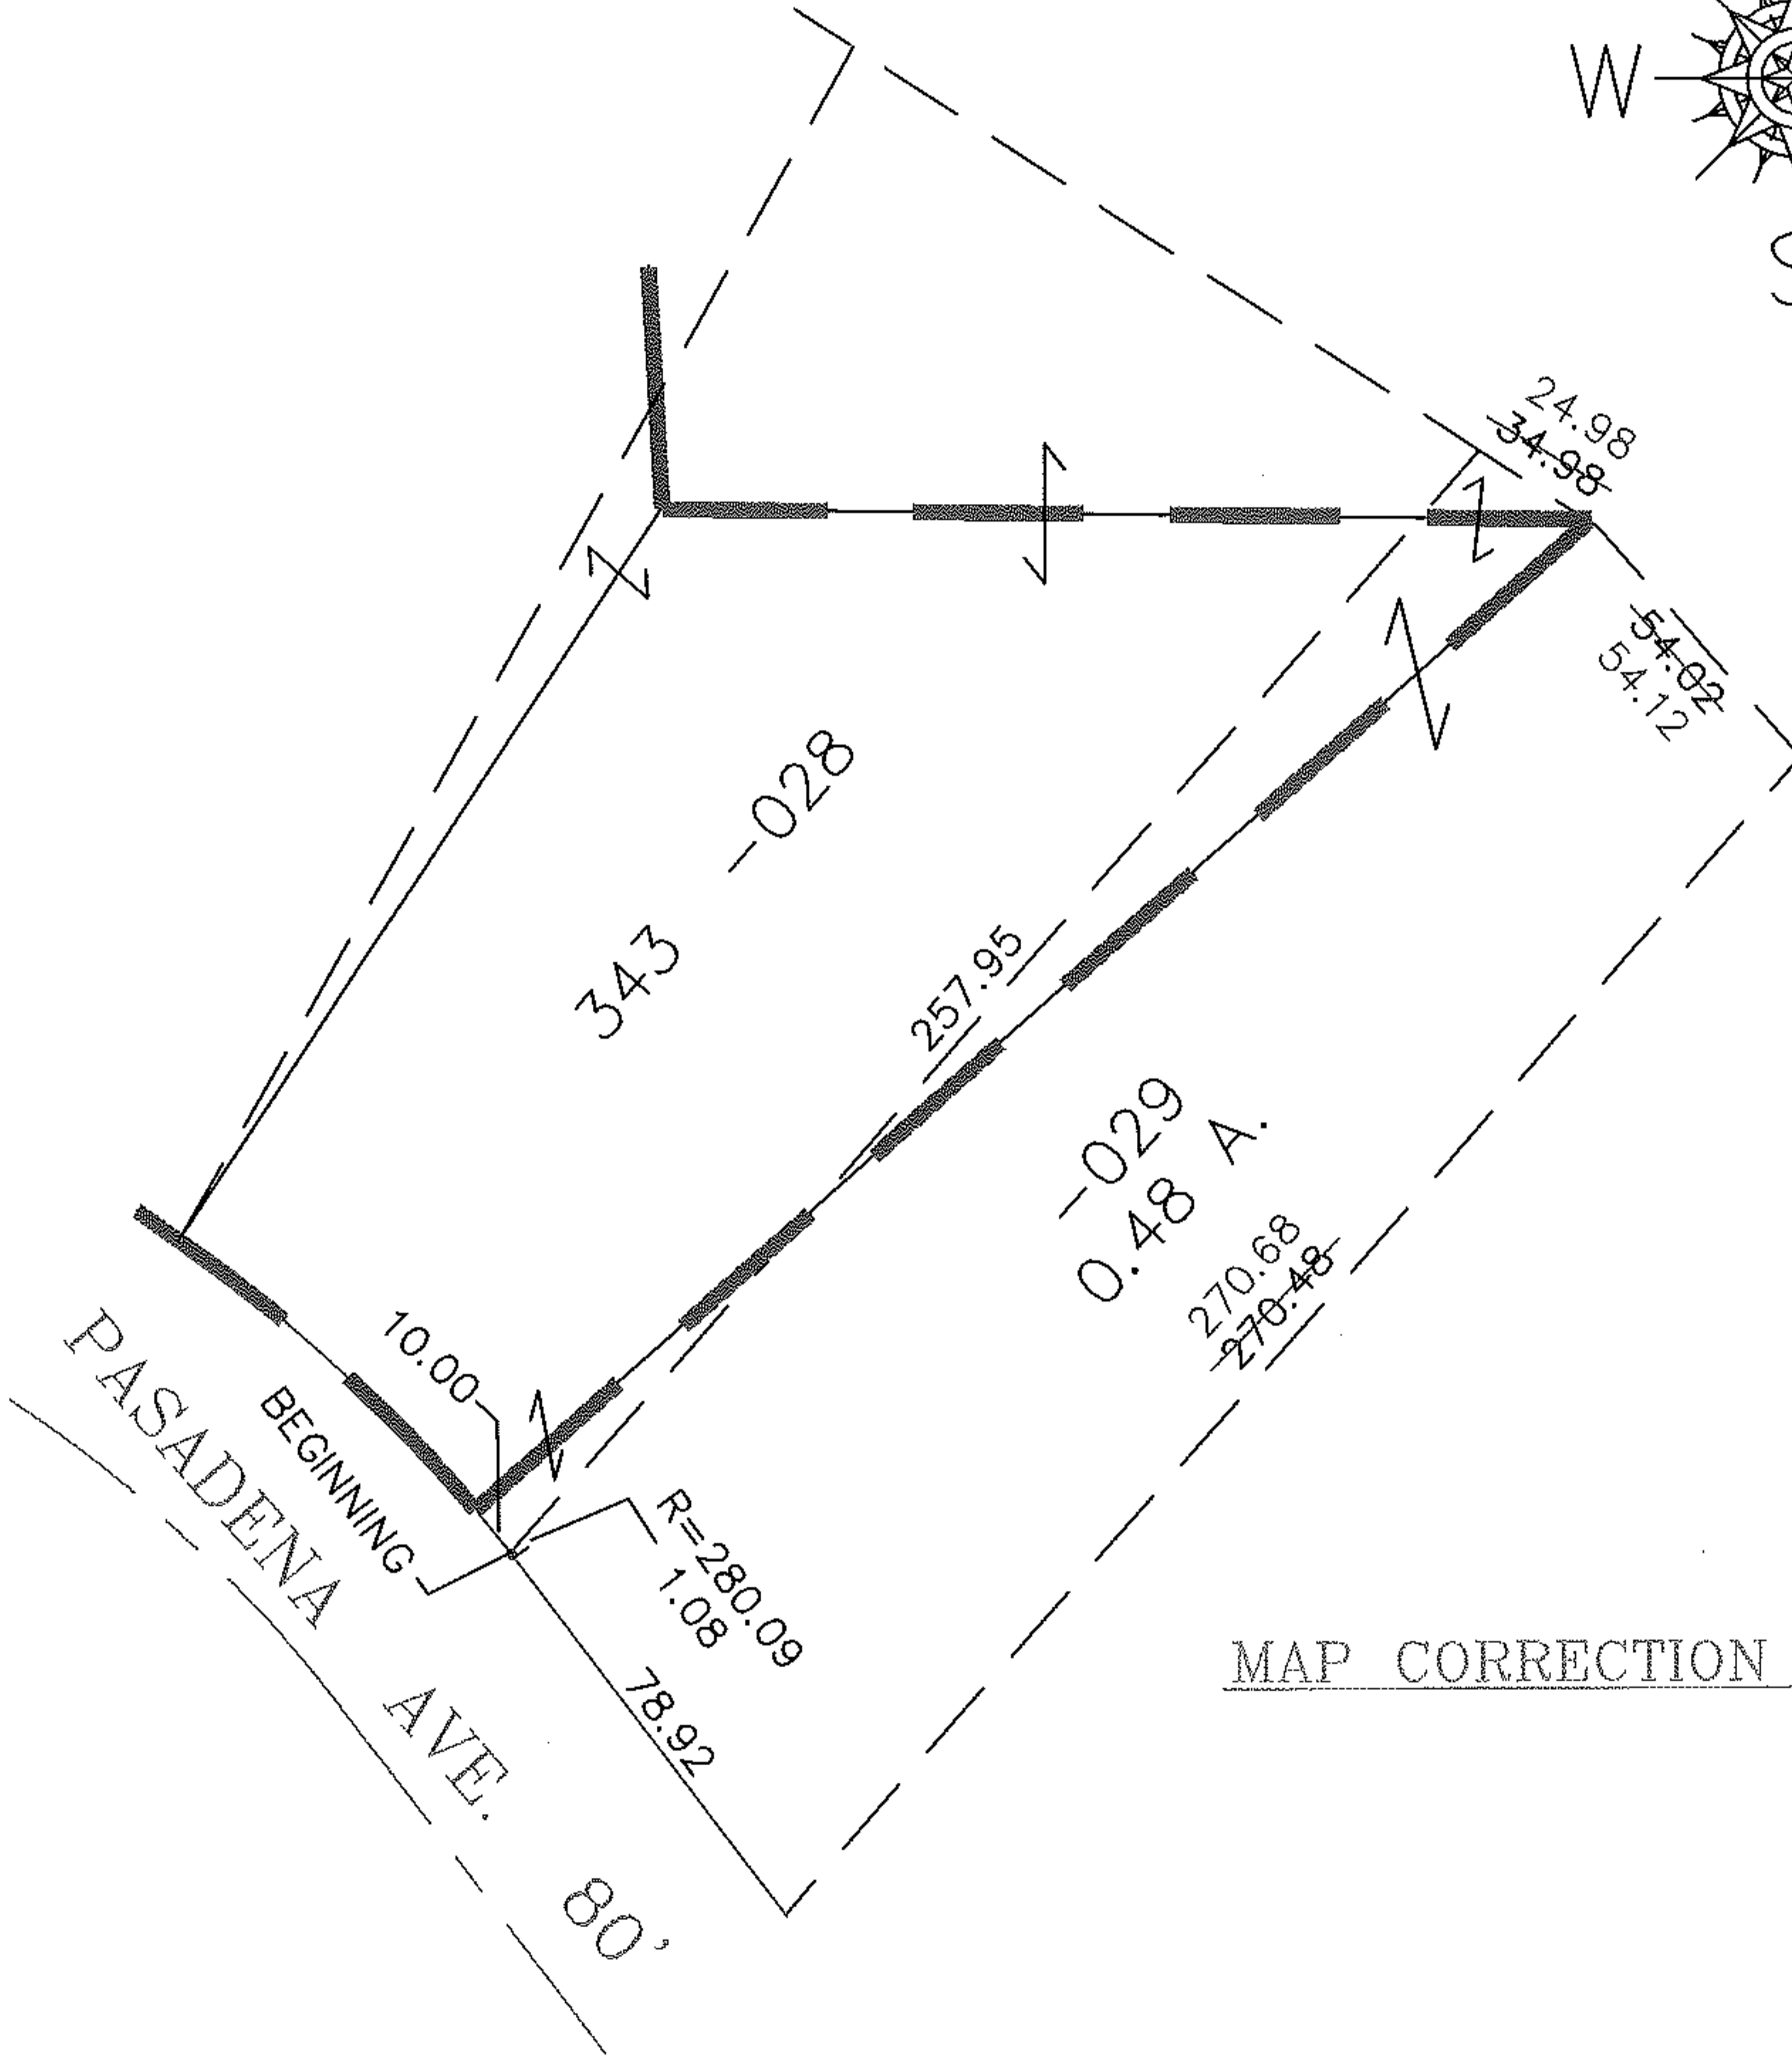


PARENT PARCEL: 06-25-176-104-029

CHILD PARCEL: XX-XX-XXX-XXX-XXX

10-02009-C

STARTING POINT: I.P. FD., NORTH LINE OF PASADENA AVE, AND S.W. CORNER OF
W. LEROY & MARJORIE OPEL. BEING 10' S.E. OF THE S.E. CORNER OF
SUBLOT 343 IN SPRING VALLEY LAND CO'S SUB. NO. 4 VOL. 13 PG. 7 & 8

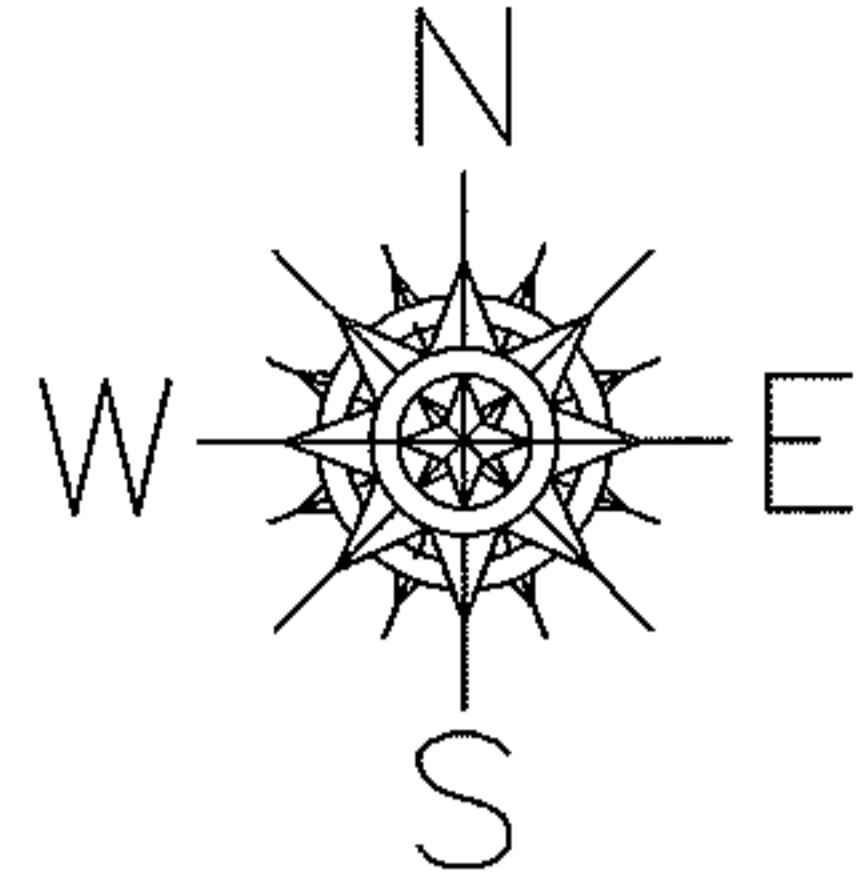

MAP CORRECTION ONLY

SPLITS/DEEDS PROCESSED

LORAIN COUNTY TAX MAP DEPARTMENT
226 MIDDLE AVE. ELYRIA, OHIO

SURVEYED BY: NONE
CLOSURE: 0.02 : 10,000
MAP PAGE(S): 6-51
APPROVED BY: TJS DATE: 4/13/10
SCALE: 1" = 50' PRIOR INST.: 20050095462