

PARENT PARCEL: 05-00-006-000-039, -040

CHILD PARCEL: 05-00-006-000-226, -227

STARTING POINT: CENTERLINE OF OAK POINT RD & O.L. 6

05 - 02010

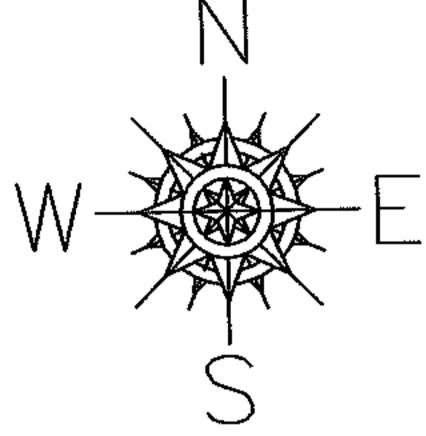

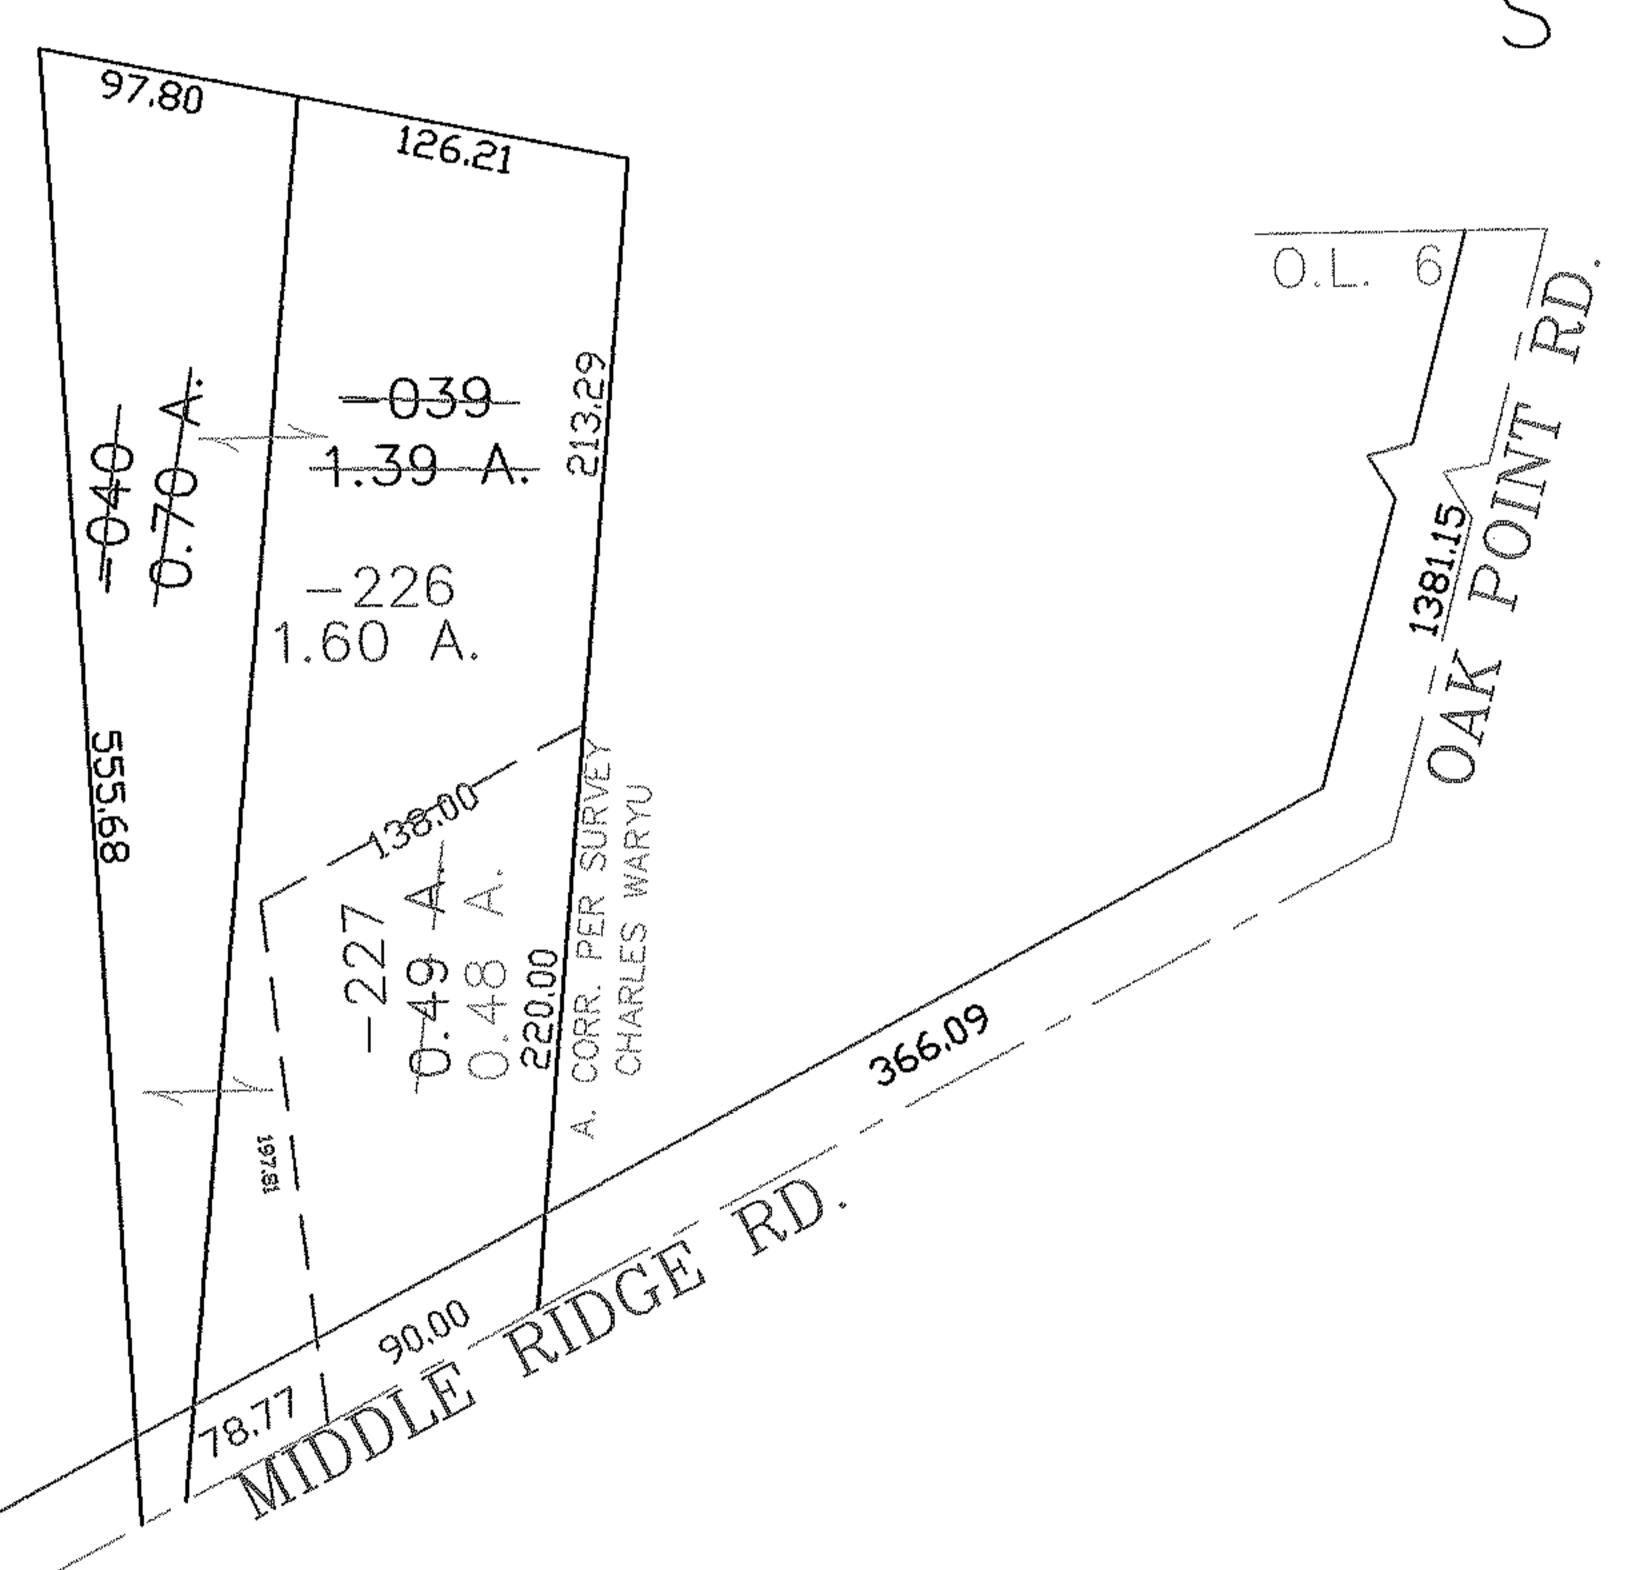

SPLITS/DEEDS PROCESSED

LORAIN COUNTY TAX MAP DEPARTMENT 226 MIDDLE AVE. ELYRIA, OHIO

- 10	SURVEYED BY: CLOSURE:0.00			·
	MAP PAGE(S):	05-00-0	006-A	
	APPROVED BY:_ SCALE: 1"= 100	Jah _ Prior I	DATE: NSTRUMENT:	9-22-05 20050064665